

Inspection Photos

Location Number: 318489



Photo 1



Photo 2

Inspection Photos



Photo 3

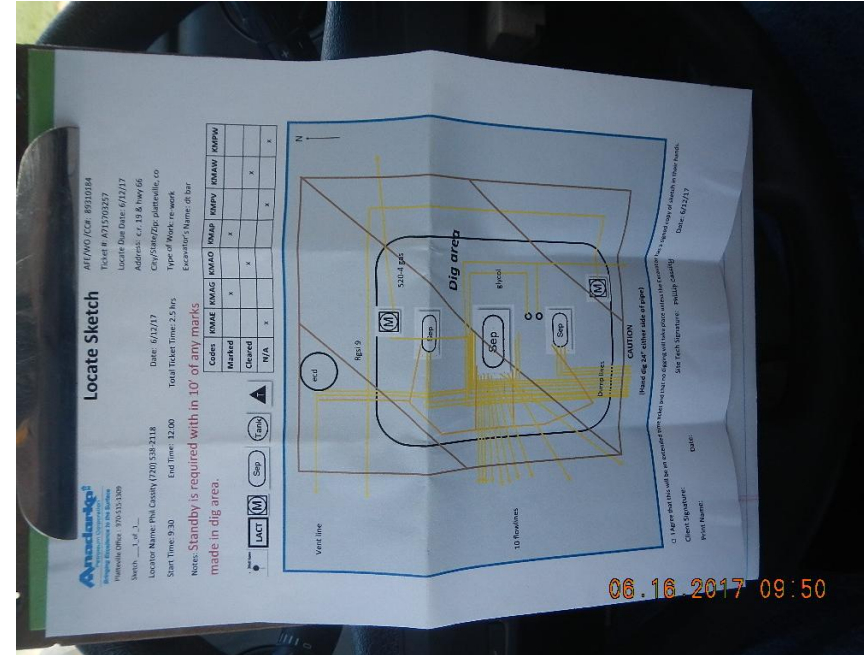


Photo 4

Inspection Photos



Photo 5