

Note:
 The measurement for determining any Designated Setback Location shall be made from the center of the Well nearest any Building Unit to the nearest wall or corner of such Building Unit.

Building	-	338'
Building Unit	-	502'
HOBU	-	3328'
DOAA	-	N/A
Public Road	-	616'
Above Grnd Util.	-	181'
Railroad	-	3952'
Property Line	-	295'

Current Surface Land Use :
 Undeveloped Lands

- Legend**
- ◊ - Field Surveyed Section Corner
 - ◆ - Field Surveyed Quarter Corner
 - ⊙ - Calculated Section Corner Location
 - ⊕ - Field Surveyed 1/6 Corner

Surface: 23A-18-07-95
 2256' FNL
 743' FWL
 Gnd El= 5098
 Pad El= 5100
NAD83
 Lat: 39.4388105222°N
 Long: 108.046269272°W


Bottom: 23A-18-07-95
 2391' FSL
 1901' FWL
NAD83
 Lat: 39.436971501°N
 Long: 108.042150100°W

Notes:

1. LATITUDE AND LONGITUDE COORDINATES ARE DIFFERENTIALLY CORRECTED AND BASED ON PUBLISHED NGS CONTROL STATION "WDP-5". SYSTEM: UTM ZONE: 13 NORTH DATUM: NAD 1983 (CONUS)
2. ELEVATIONS ARE BASED ON NAVD OF 1929.
3. ALL BOTTOM AND TOP HOLE LOCATIONS ARE MEASURED 90 DEGREES FROM SECTION LINE.
4. USGS QUADRANGLE MAP "PARACHUTE".
5. CURRENT SURFACE LAND USE: RANGE LAND.
6. PDOP AT THE TIME OF LOCATION OF SURFACE WELL = 1.7
7. GPS OPERATOR: P. HOFFMANN

SURVEYOR'S CERTIFICATE

I, SCOTT E. AIBNER, A REGISTERED AND SURVEYOR, LICENSED UNDER THE LAWS OF THE STATE OF COLORADO, DO HEREBY CERTIFY THAT THE SURVEY SHOWN HEREON WAS PREPARED BY RIVER VALLEY SURVEY, INC., FOR URSA OPERATING COMPANY LLC, BY ME OR UNDER MY DIRECT SUPERVISION AND HAS BEEN STAKED ON THE GROUND AND SHOWN ON THE PLAT AND THAT THIS PLAT IS A TRUE REPRESENTATION THEREOF.

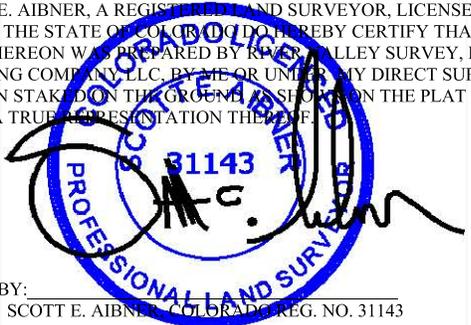

BY: SCOTT E. AIBNER, COLORADO REG. NO. 31143

Prepared For: Ursa Operating Company LLC
 Proposed BMC B 23A-18-07-95 Well, Surface Situate in
 The SW 1/4 NW 1/4 Section 18, Township 7 South, Range 95
 West of the 6 th. Principal Meridian, County of Garfield,
 State of Colorado.



River Valley Survey, Inc.
 110 East 3rd. Street, Suite 213
 Rifle, Colorado 81650
 Ph: 970-379-7846

Project: RVS 06001-58B	
Field Date: 06-16-14	Scale: 1"= 1000'
Date: 06-28-17	Sheet: 1 of 1

303.a Form 2
BMC B Pad
BMC B 23A-18-07-95
 Section 18, Township 7 South, Range 95 West