




Washburn Land Surveying
 www.WashburnSurveying.com
 970-232-9645

LOCATION DRAWING


BARR 5N65W11TY PAD

SECTION: 11
 TOWNSHIP: 5N
 RANGE: 65W
 6TH P.M.
 WELD COUNTY, CO

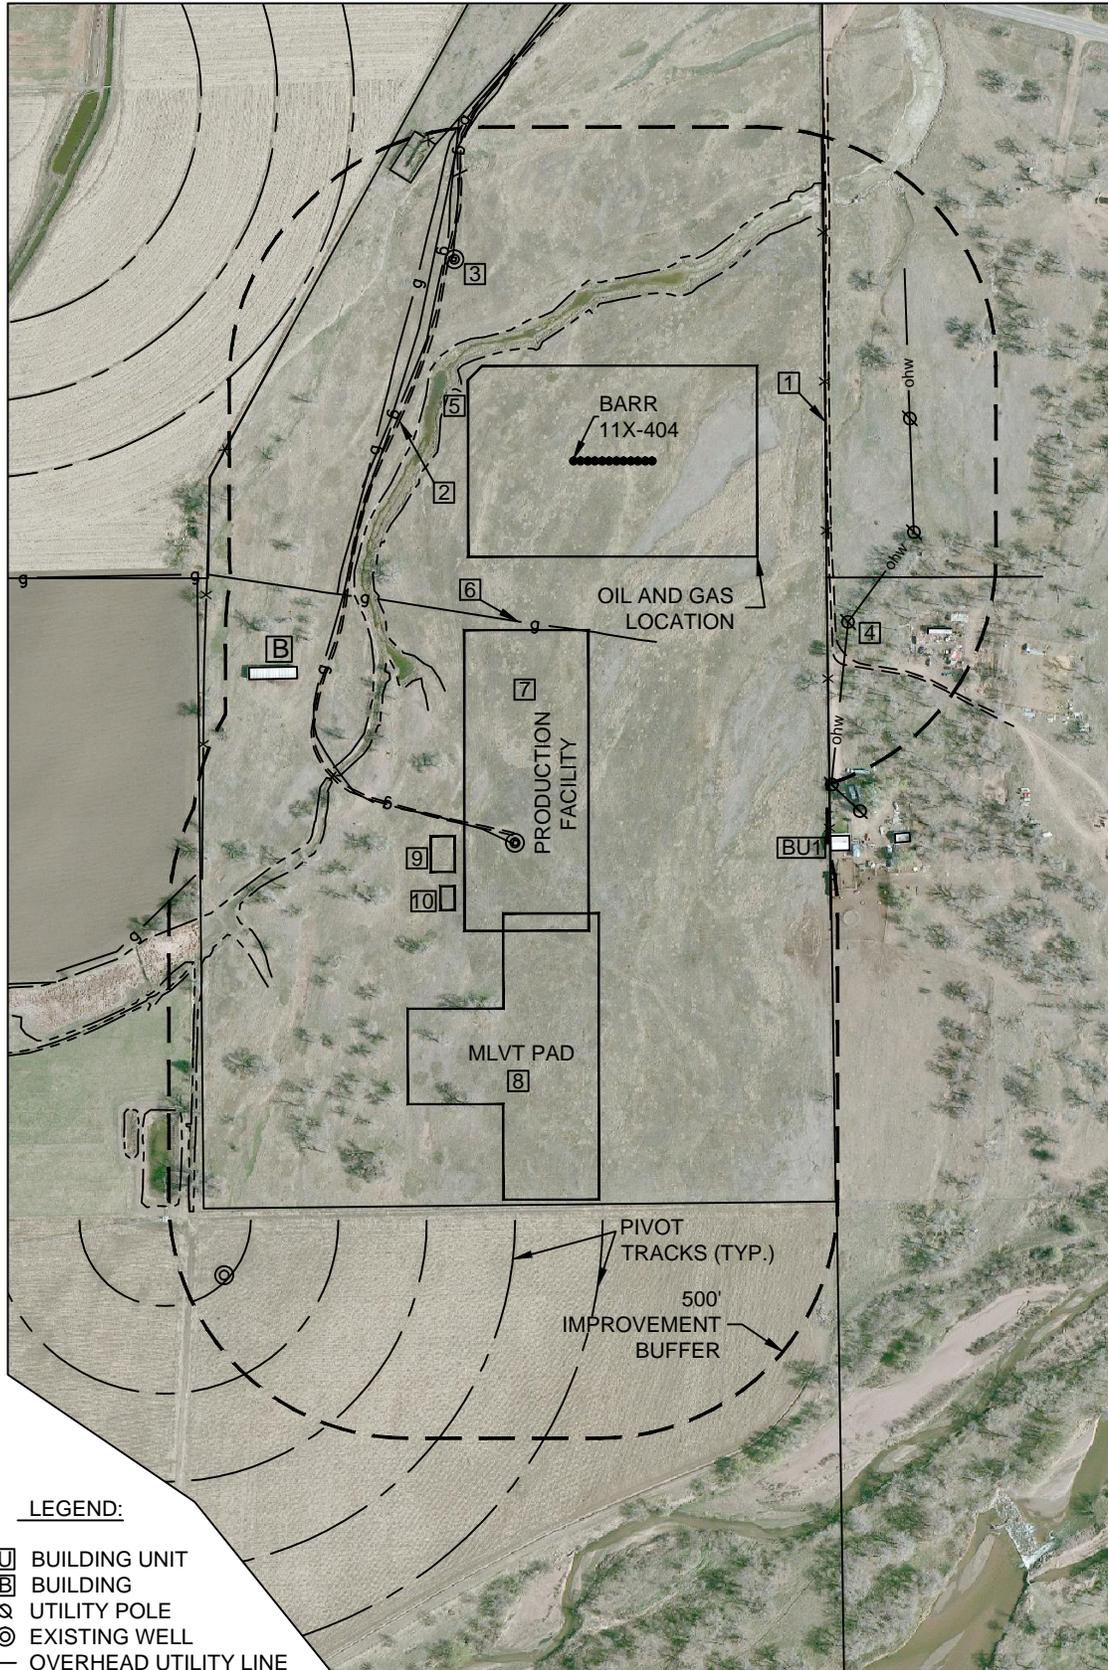

LEGEND:

- BU BUILDING UNIT
- B BUILDING
- UTILITY POLE
- EXISTING WELL
- ohw— OVERHEAD UTILITY LINE
- g— GAS LINE
- - - - EDGE OF ROAD/ACCESS
- - - - TOP OF BANK
- x— FENCE LINE
- PROPERTY LINE

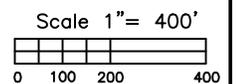



Washburn Land Surveying
www.WashburnSurveying.com
970-232-9645

LOCATION DRAWING

BARR 5N65W11TY PAD

SECTION: 11
TOWNSHIP: 5N
RANGE: 65W
6TH P.M.
WELD COUNTY, CO

IMPROVEMENTS

(MEASUREMENTS ARE FROM THE PROPOSED BARR 11X-404 WELL LOCATION)

- [BU1]** BUILDING UNIT: 953' SE
- [B]** BUILDINGS: 721' SW, 821' SE (ABANDONED UNOCCUPIED TRAILER), 1031' SE & 1019' SE
- [1]** PROPERTY LINE: 529' E, 652' NW & 1558' S
- [2]** ACCESS: 366' NW & 531' E
- [3]** EXISTING WELL: 490' NW (CAESAR #3-11), 809' SW (BETH #1) & 1856' SW (CASS #5)
- [4]** OVERHEAD UTILITY LINE: 667' SE
- [5]** DITCH: 275' NW & 1310' SW
- [6]** GAS LINE LOCATES: 350' SW, 380' NW, 390' NW & 412' NW
- [7]** PROPOSED PRODUCTION FACILITIES: 354' S
- [8]** PROPOSED TEMPORARY MLVT PAD: 948' S
- [9]** TEMPORARY WATER TANK AREA: 824' SW
- [10]** OIL METERING AREA: 925' SW