
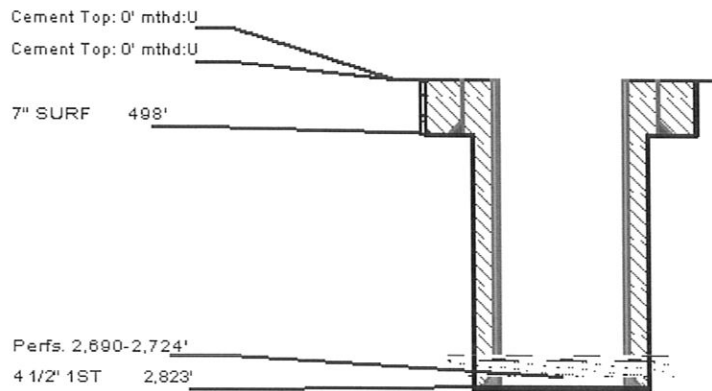


Well Completion Diagram

API Well No: 05-125-07820-00-							
Owner:	J-W OPERATING CO			Well Name:	KLINZMAN		
County:	YUMA	Field:	OLD BALDY	Pool:			
Coordinates: X	1740 FEL	Y	600 FNL	Sec: 11	Twp: 4N	Rng: 46W	

Note: Changes to the drawing do not effect the database

Bore Diameters (in.)

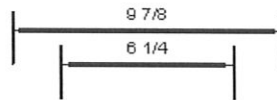

