
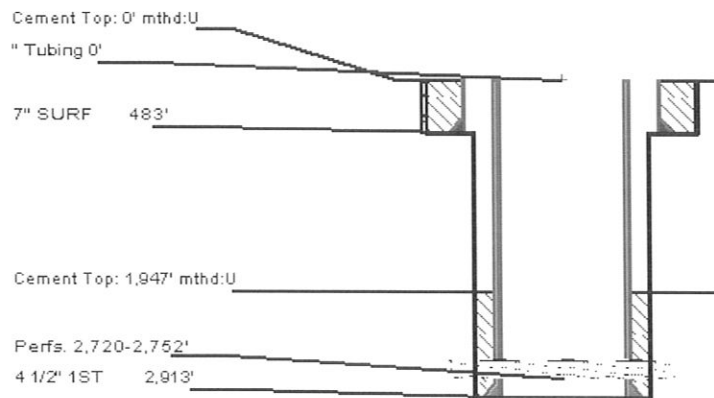


Well Completion Diagram

API Well No: 05-125-08291-00-						
Owner:	ROSEWOOD RESOURCES INC			Well Name:	OESTMAN	
County:	YUMA	Field:	BUCKBOARD	Pool:		
Coordinates: X	600 FWL	Y	600 FNL	Sec:	15	Twp: 3N Rng: 46W

Note: Changes to the drawing do not effect the database

Bore Diameters (in.)

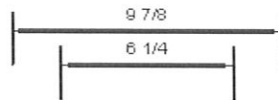

