


WELLBORE DIAGRAM
EXTRACTION OIL & GAS
WINTER 15-19
SWSE SEC 19 T6N R64W
WELD COUNTY
05-123-13198

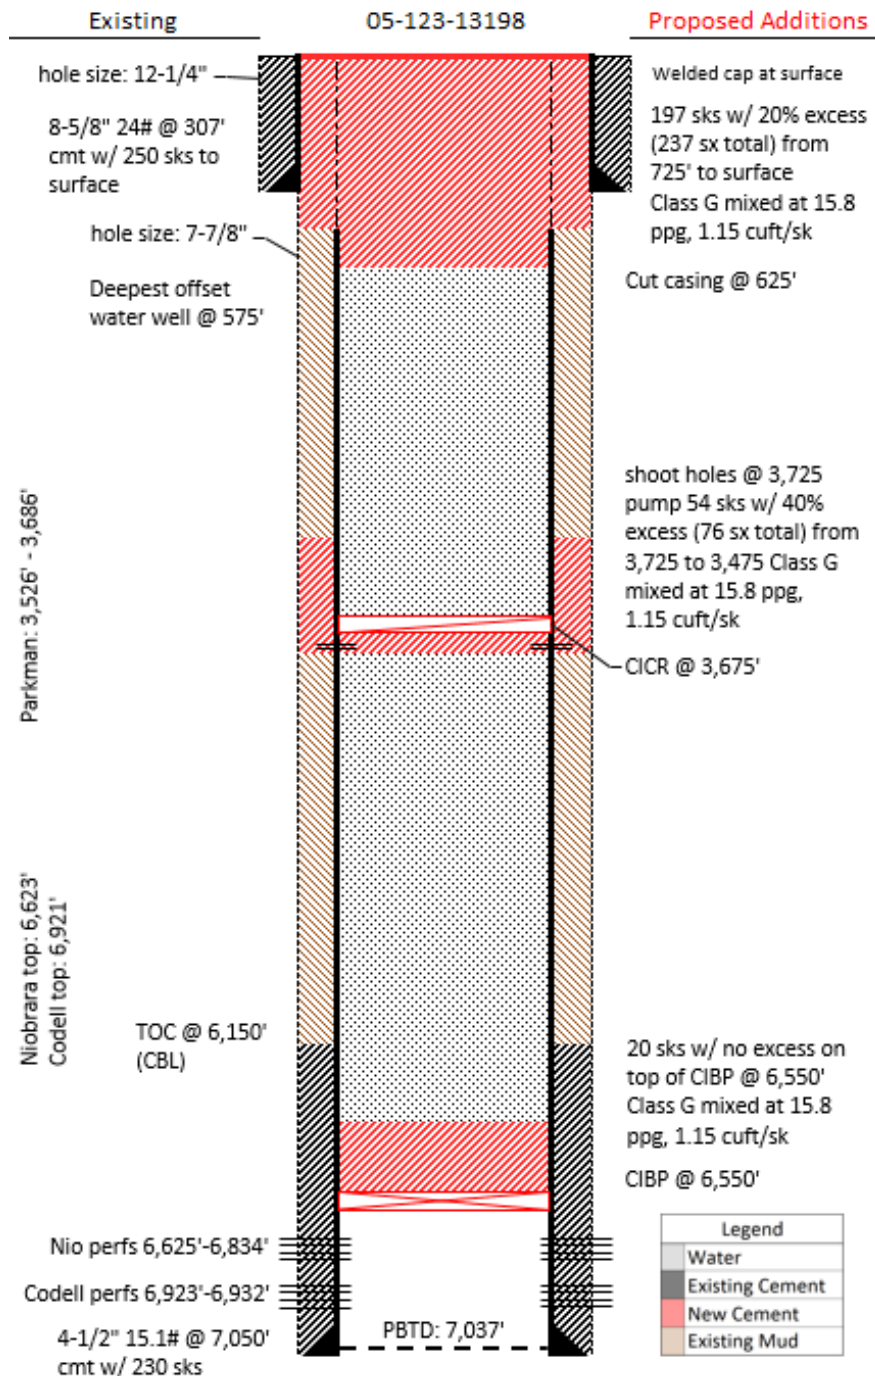

Legend	
	Water
	Existing Cement
	New Cement
	Existing Mud