
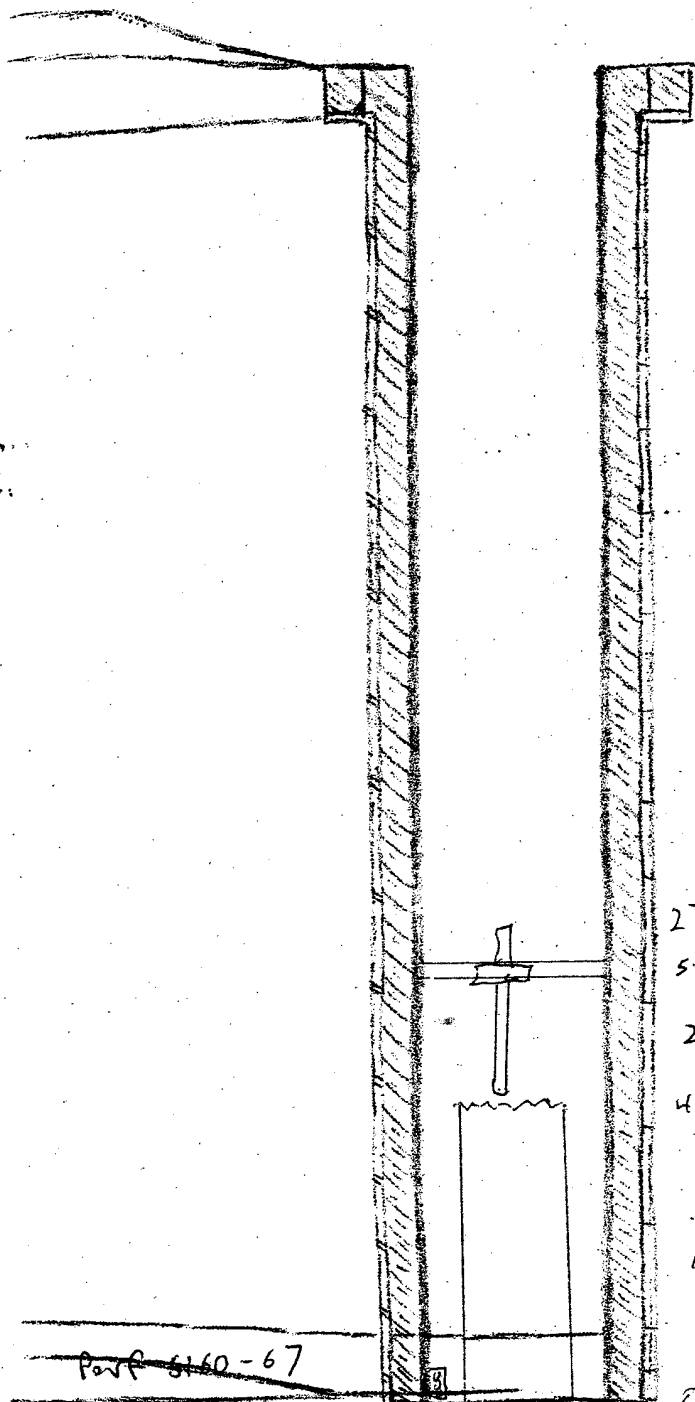


Owner: Magpie Operating Inc Well Name: LARSU #43
 County: Washington Field: Little Beaver Pool: D Sand
 Coordinates: Sec: 5 Twp: 2 S Rng: 56

Bore Diameters (in.)

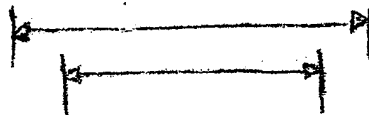

10 3/4" surf casg @ 97'
 cut w/ 55sx

2 7/8" tbg cut @ 4600
 stack tbg anchor 4620

2jts 2 7/8" tbg + p-g barrel

4 1/2" wash p-p @ 4700

5 1/2" casg @ 5167' cut w/ 150sx
 15.5x

Perf 5160-67

Open Hole 5167-5240