# WELL LOCATION FOR MERCHANT ENERGY PARTNERS, LLC

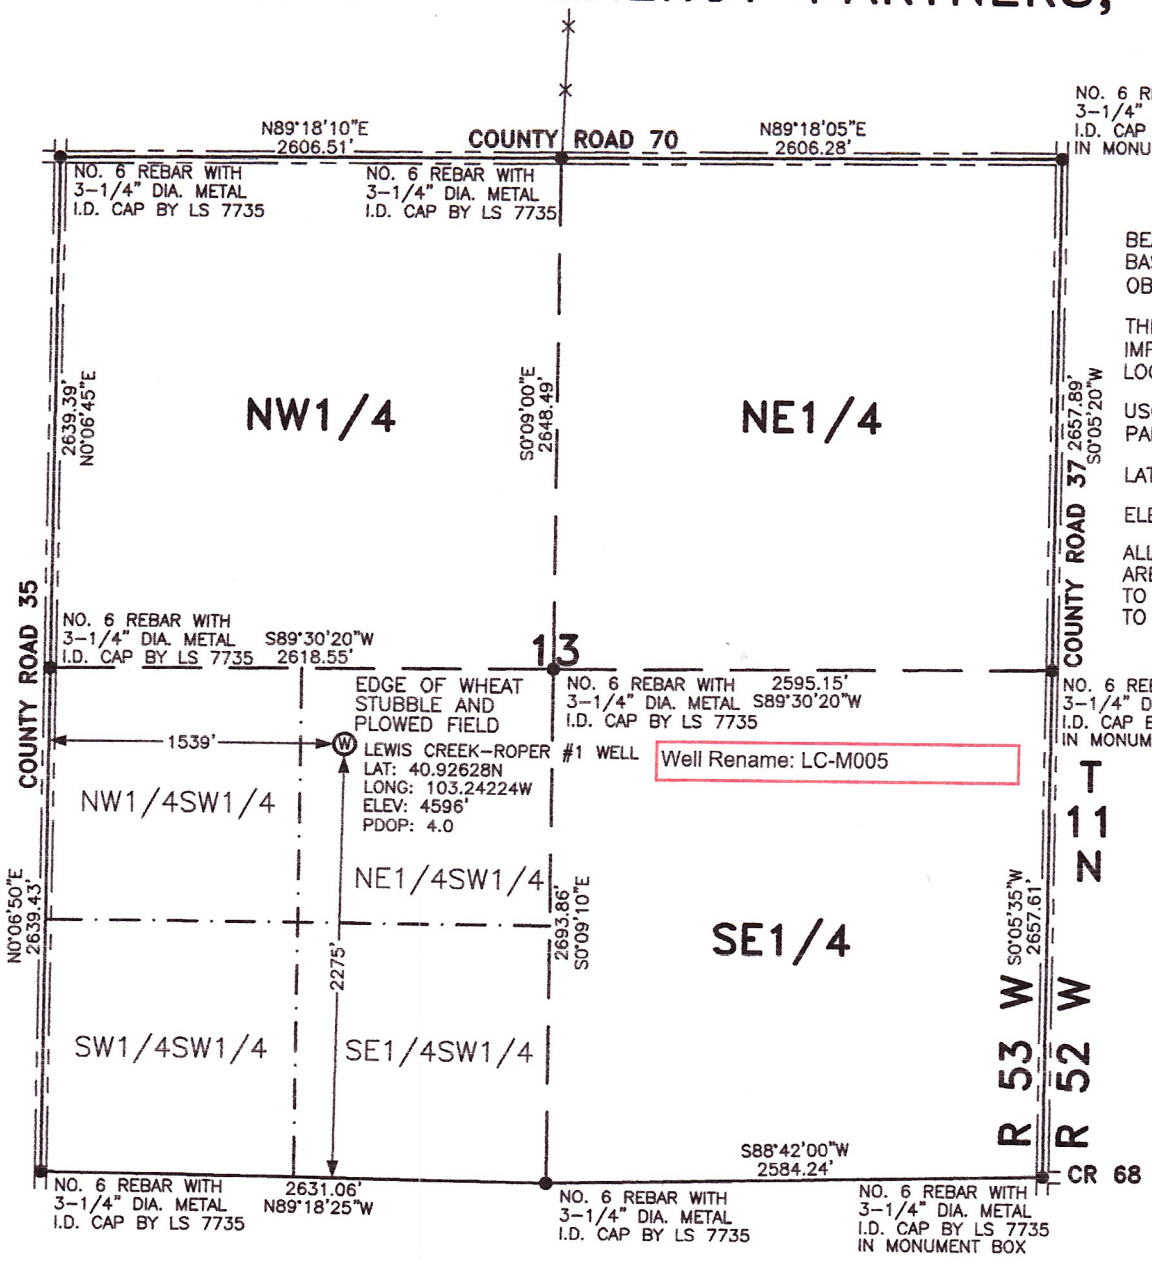


## NOTES

BEARINGS SHOWN HEREON ARE BASED UPON RTK GPS OBSERVATIONS

THERE ARE NO VISIBLE IMPROVEMENTS WITHIN 400' OF LOCATION.

USGS QUAD MAP: PADRONI NW, COLO.

LAT/LONG VALUES ARE NAD83

ELEVATIONS BASED ON NAVD 1988

ALL DISTANCES TO SECTION LINES ARE MEASURED PERPENDICULAR TO AND ARE AT RIGHT ANGLES TO SAID SECTION LINES.

## LEGEND

- FIELD SURVEYED WELL LOCATION
- ROAD
- FENCE

THIS WELL LOCATION PLAT HAS BEEN PREPARED FOR MERCHANT ENERGY PARTNERS, LLC, TO LOCATE THE LEWIS CREEK-ROPER #1 WELL BEING 1539 FEET FROM THE WEST LINE AND 2275 FEET FROM THE SOUTH LINE IN THE NE1/4SW1/4 OF SECTION 13, TOWNSHIP 11 NORTH, RANGE 53 WEST OF THE 6TH P.M., LOGAN COUNTY, COLORADO. THE SURFACE ELEVATION AT THIS POINT IS 4596 FEET. THIS IS NOT A LAND SURVEY PLAT.

N

SCALE: 1" = 1000'

1000 500 0 1000

SCALE IN FEET

COLORADO LICENSED NICOLE F. MATTA 38044 8-18-10 PROFESSIONAL LAND SURVEYOR

**LEIBERT-McATEE & ASSOCIATES, INC.**
P.O. BOX 442 615 SOUTH TENTH AVENUE
STERLING, CO 80751 970-522-1960

| | | |
|---|---|---|
| FIELD DATE: 8-10-10 | DWG DATE: 8-18-10 | GPS OPERATOR: DARREN VEAL |
| LEWIS CREEK-ROPER #1 | DWG NO. 1544-09 | SHEET 1 OF 2 |