


\* record gps depths on this sheet

COLORADO PIT CLOSURE - SAMPLING MAP

WELL NAME: State of CO 2 - 100403

N 40.91488

W 108.24438

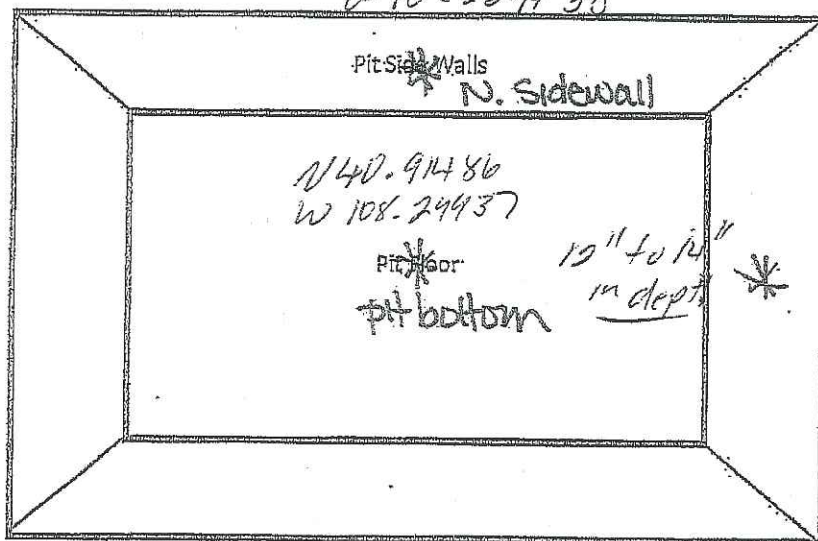

**LEGEND**

- ★ Pit Low-Point - Sample Point
- Pit-Side-Wall - Sample Point
- Off Site - Sample Points (3)

Remember to put GPS coordinates  
on all sample sites

N 40.91483

W 108.24435

E. Sidewall



X-no offsites needed



100403

SAMPLE LOCATIONS

Legend



Feature 1



STATE OF COLORADO 2

STATE OF COLORADO 2 (40.91488, -108.29938)

(40.91486, -108.29937)

40.91483, -108.29935

Google earth



100 ft