


WELLBORE DIAGRAM
Vessels Oil and Gas
K&M Co. #1
SENW SEC 17 7N67W
WELD COUNTY
05-123-10841

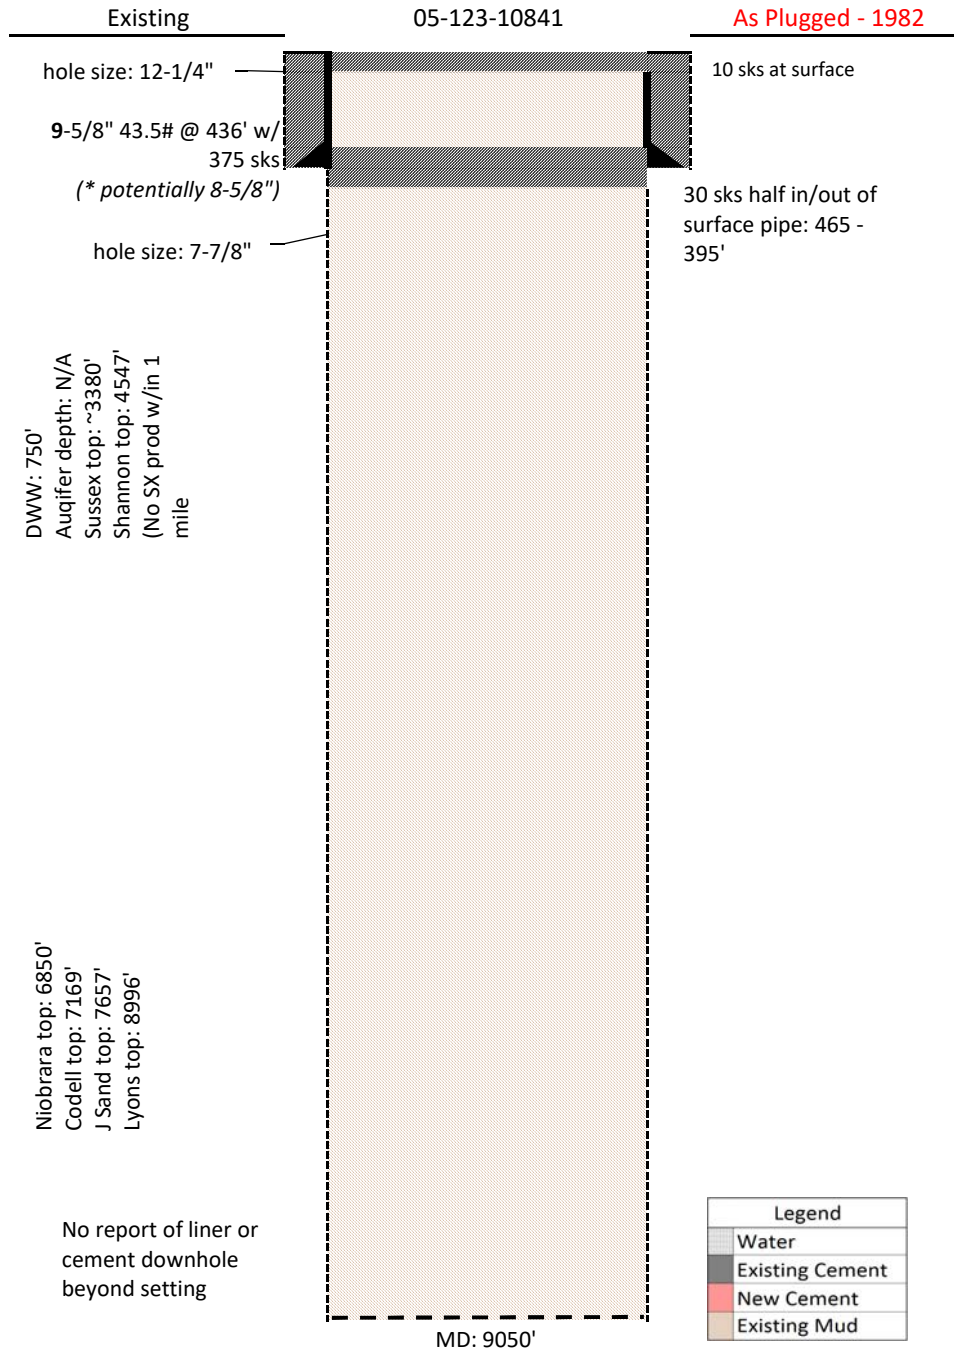

WELLBORE DIAGRAM
Vessels Oil and Gas
K&M Co. #1
SENW SEC 17 7N67W
WELD COUNTY
05-123-10841

