


**TEP Rocky Mountain LLC
SR 431-12
Rulison Field
Section 12 T 7S-R94W**

**Formation Tops
(Measured Depths)**

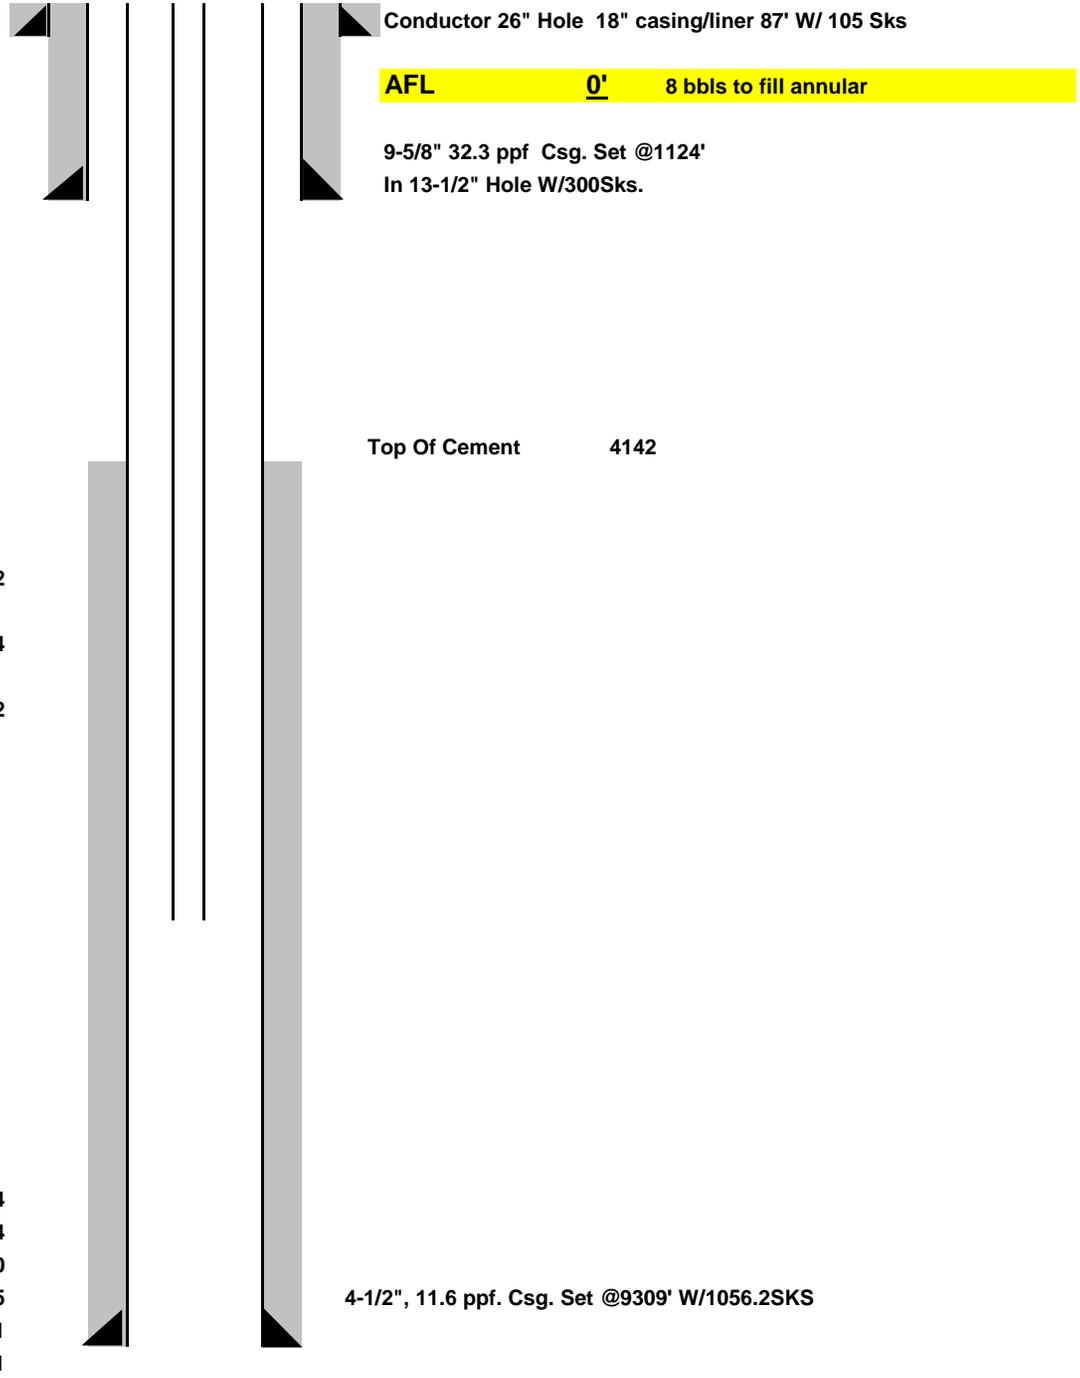

"G" Sand @ 3242
Mesaverde @ 5514
Cameo @ 8462

Tubing not set

PBTD @ 9284
Float Collar @ 9284
TMD @ 9320
TVD @ 9285
Est.Top Perf @ 6931
Top Of Gas @ 7131