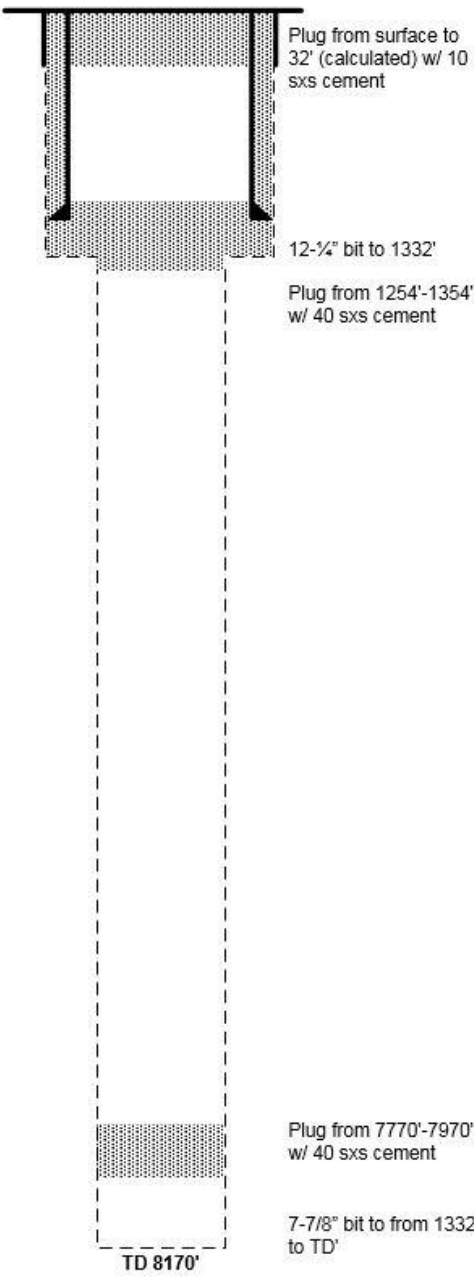


**Attachment #1 – Current Plugged Wellbore Diagram**

Crestone Peak Resources	Current P&A'd Wellbore Diagram																				
<p> <b>Well</b> : Bare Spaces 11-36  <b>Field</b> : Wattenberg  <b>County</b> : Weld                      <b>State</b> : Colorado  <b>Surface</b> : Lat: 40.012389      Long: -104.731147                         : 990 FNL, 1120 FWL NWNW Sec 36 T1N R66W  <b>API #</b> : 05-123-18955  <b>Grd Elev</b> : 5062' GR                      <b>KB Elevation:</b> 5072' KB         </p>																					
<p><u>Log Tops:</u></p> <table style="width: 100%;"> <tr><td>Fox Hills Base</td><td>1165'</td></tr> <tr><td>Upper Pierre Base</td><td>2164'</td></tr> <tr><td>Sussex</td><td>4682'</td></tr> <tr><td>Shannon Base</td><td>5475'</td></tr> <tr><td>Niobrara</td><td>7171'</td></tr> <tr><td>Codell</td><td>7562'</td></tr> <tr><td>J Sand</td><td>8006'</td></tr> </table> <p><u>Surface Casing</u>            8-5/8" 24# J-55 Surface            Casing set @ 1317', cmt'd w/            535 sx. 30 jts.</p>	Fox Hills Base	1165'	Upper Pierre Base	2164'	Sussex	4682'	Shannon Base	5475'	Niobrara	7171'	Codell	7562'	J Sand	8006'	 <div style="border: 1px solid black; padding: 5px; margin-top: 10px;"> <p><b>Well History:</b></p> <table style="width: 100%;"> <tr><td>Spud</td><td>07/28/1995</td></tr> <tr><td>TD</td><td>08/04/1995</td></tr> <tr><td>P&amp;A'd</td><td>08/05/1995</td></tr> </table> </div>	Spud	07/28/1995	TD	08/04/1995	P&A'd	08/05/1995
Fox Hills Base	1165'																				
Upper Pierre Base	2164'																				
Sussex	4682'																				
Shannon Base	5475'																				
Niobrara	7171'																				
Codell	7562'																				
J Sand	8006'																				
Spud	07/28/1995																				
TD	08/04/1995																				
P&A'd	08/05/1995																				
<p>Drawn by: Tyler Barela</p>	<p>Date: 12/08/2016</p>																				