


# FRANE SURVEYING INC.

Physical Address: 34834 Annie Cir.  
Mail to: Box 2372, Elizabeth, CO 80107  
Ph. 303-243-0037  
www.franesurveying.com  
Job # 17-136-SEQUOIA 1-36

Frane Surveying, in accordance with a request from **Grand Mesa Operating** has determined the location of **SEQUOIA 1-36** to be **1172 Feet FNL**, and **932 Feet FEL**, (90° off Section lines) of Section **36**, Township **7s**, Range **55w** of the 6th Principal Meridian, **Lincoln County**, Colorado.

Date: Staked on 07/21/17 drawn on 07/22/17.

Re: Staked by Elijah Frane  
Drawn: Drawn by Elijah Frane

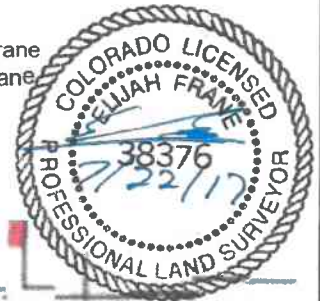

## Access Road Map

