

Final Reclamation Inspection

September 5, 2017

Operator: SLAWSON EXPLORATION COMPANY INC- #10334

API: 05-123-31826

Weld County, CO

SESE Section 36 T11N R66W

Chris Binschus
Reclamation Specialist, COGCC



COLORADO
Oil & Gas Conservation
Commission

Department of Natural Resources

Inspection Photos
Location Name: Mousetrap #36-11-66
API: 05-123-31826

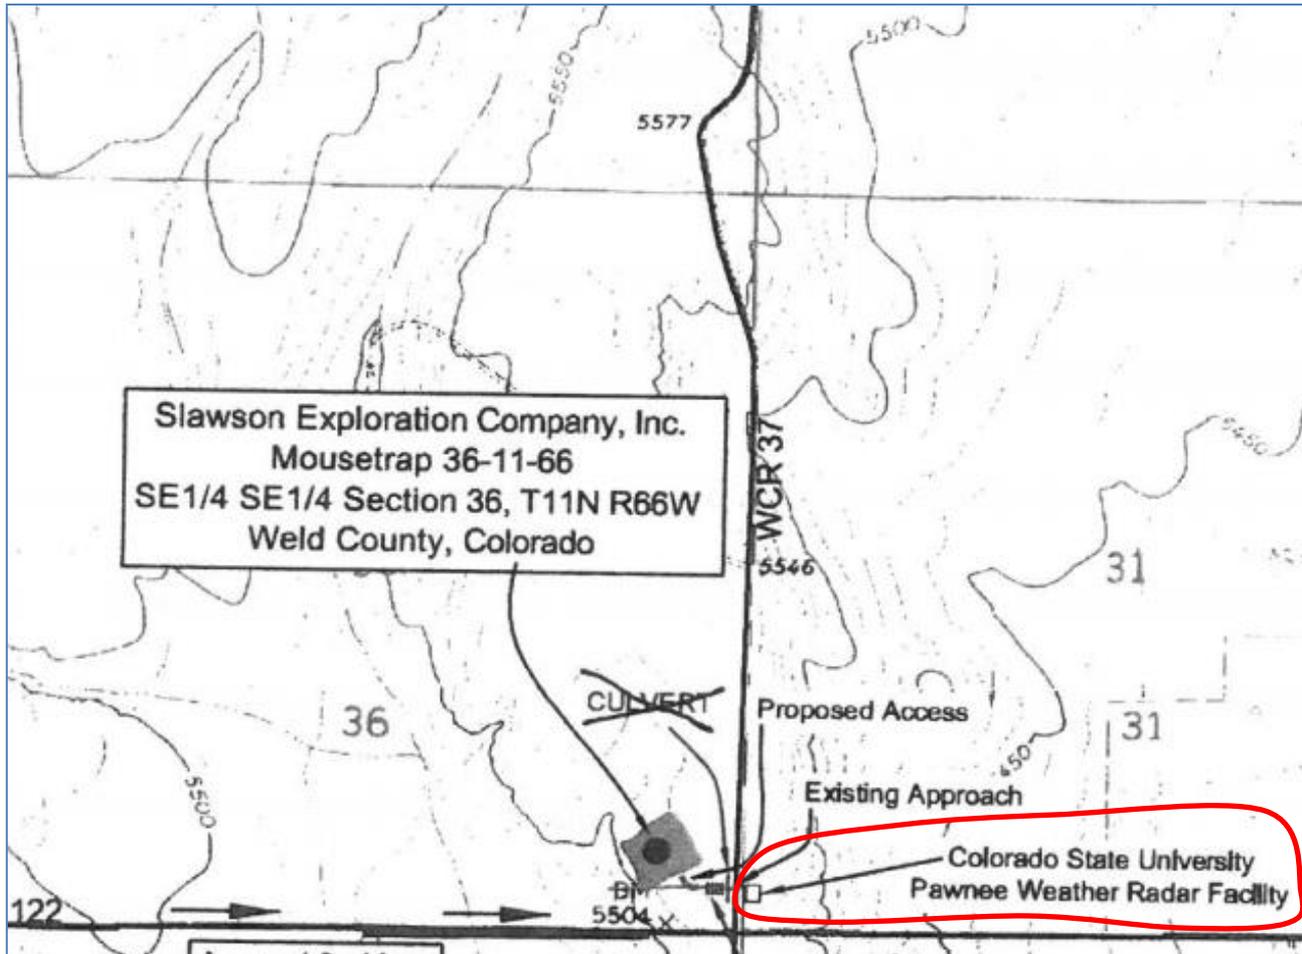


Image taken from the Access Road Map provided by the Operator. Previous inspections referred to concrete slab and vault that was thought to be left behind by the Operator. This document illustrates it was from a Colorado State University Weather Facility.