



Holloway & Holloway, Inc.  
 P.O. Box 3331  
 Greeley, CO 80633  
 (303) 867-3715  
 (303) 352-5852



NE cor. GLO  
 Brass Cap


N

N86°36'E 2576'


R58W

2625'

NW cor. GLO Brass  
 Cap

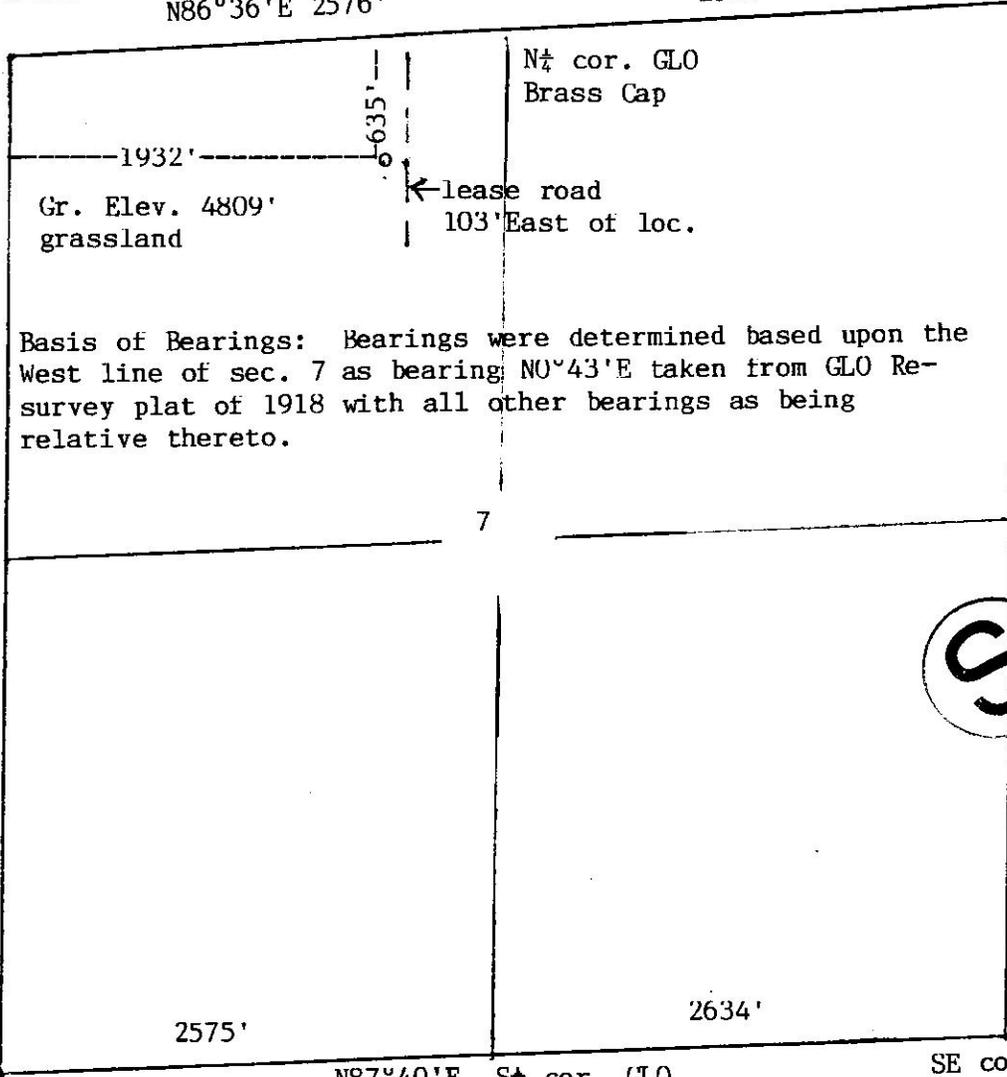


Basis of Bearings: Bearings were determined based upon the West line of sec. 7 as bearing N0°43'E taken from GLO Re-survey plat of 1918 with all other bearings as being relative thereto.

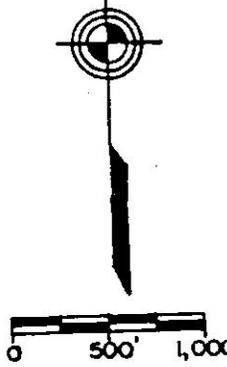

N0°43'E 5296'

T 8 N

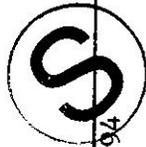

N0°40'E 5394'

SW cor. GLO Brass  
 Cap

Basis of elev spot elev  
 at SW cor. 4704'

Scale --- 1" = 1000'

In accordance with a request from Walsh Production, Inc.  
 the Undersigned has determined the location of the Lilli Unit 3-7 well  
 to be 635'FNL & 1932'FWL at right angles as co-ordinates  
 Section 7 Township 8N Range 58W of the 6th principal Meridian  
 Weld County, Colorado.

I hereby certify  
 that this oil and/or gas well location certificate was prepared for Walsh Production, Inc.  
 that it is not a land survey plat or improvement survey plat, and that it is not to be relied upon for the  
 establishment of fence, building or other future improvement lines

Date 8-19-2000

*Bobby G. Holloway*  
 Holloway & Holloway, Inc.  
 State of

