



Welker 42-11A "As is" and "Plugged and Abandoned " Wellbore Diagrams

Wellbore Diagram "As Is" - 20 July 2017

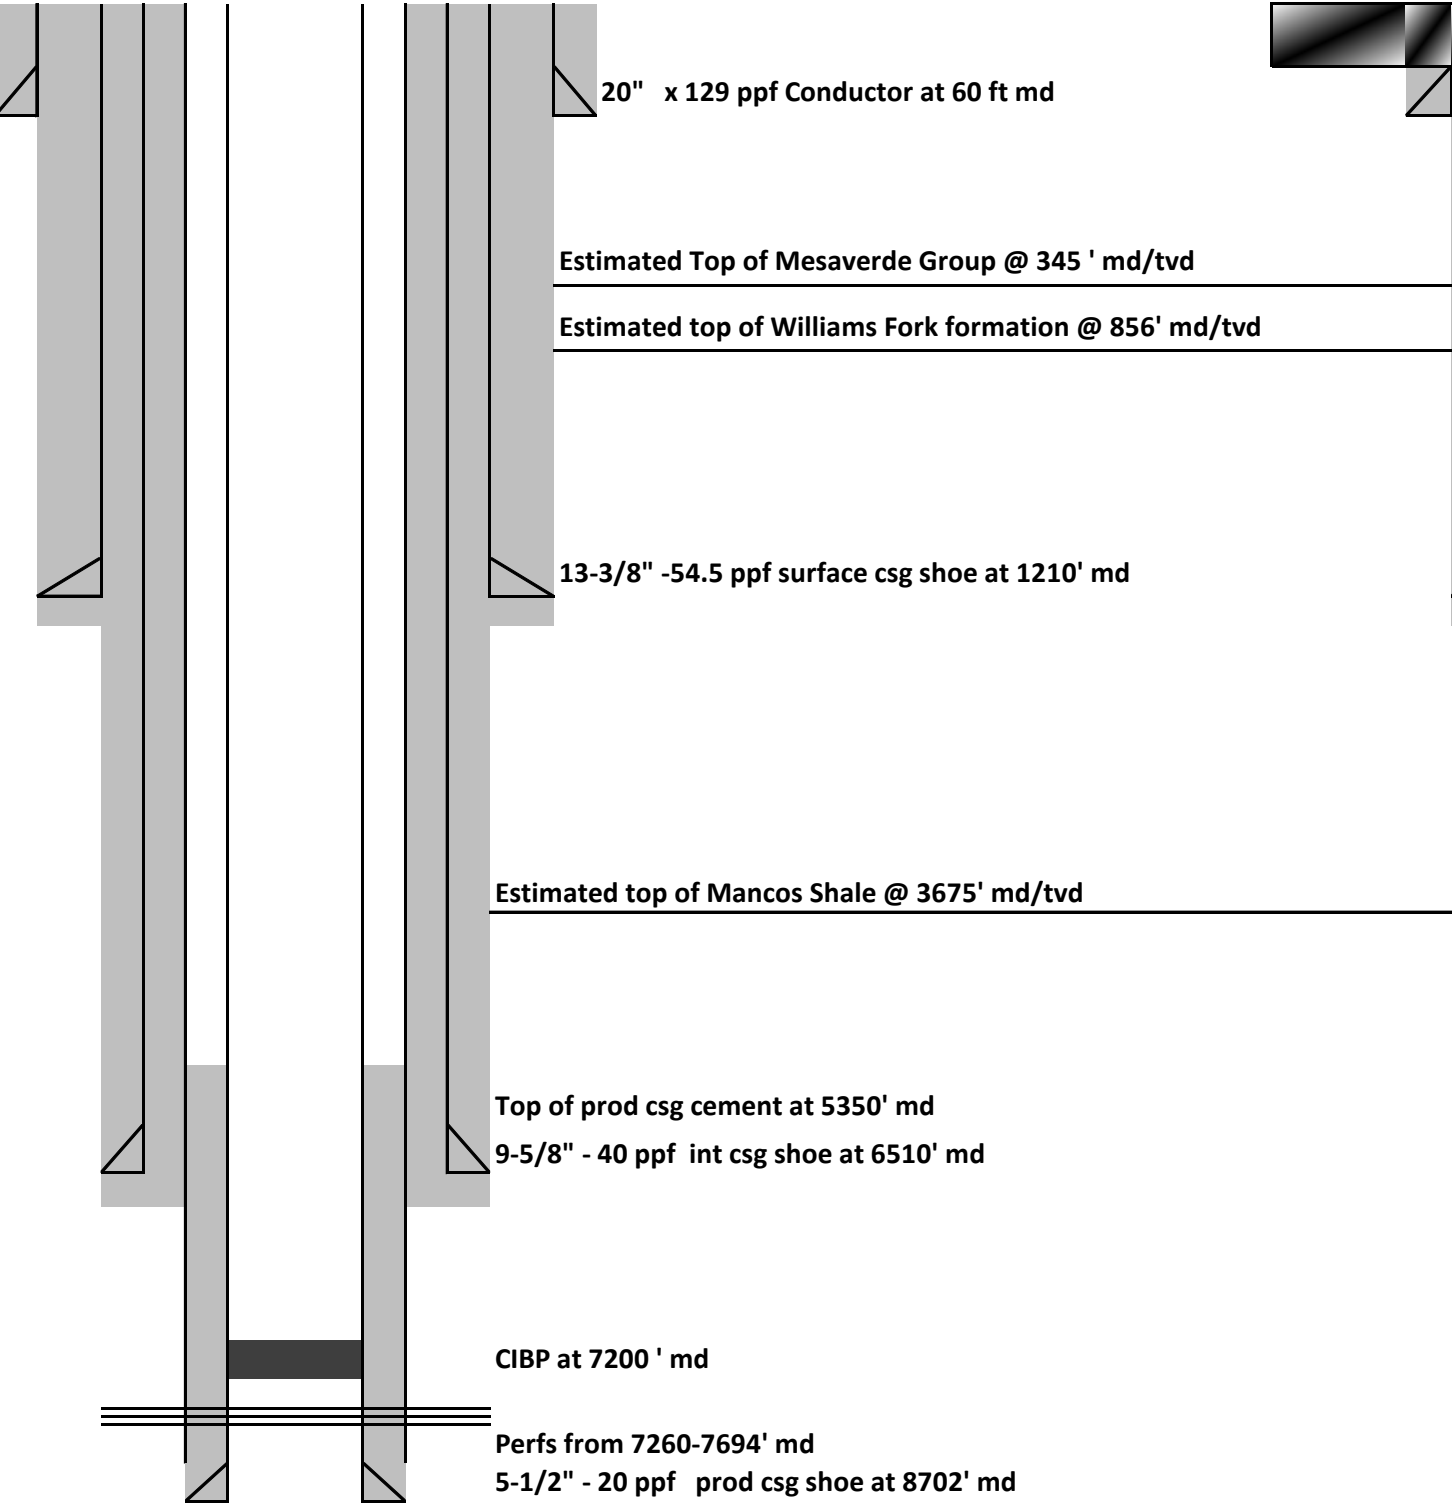

Gray shading indicates current cement

Wellbore Diagram After P & A Complete

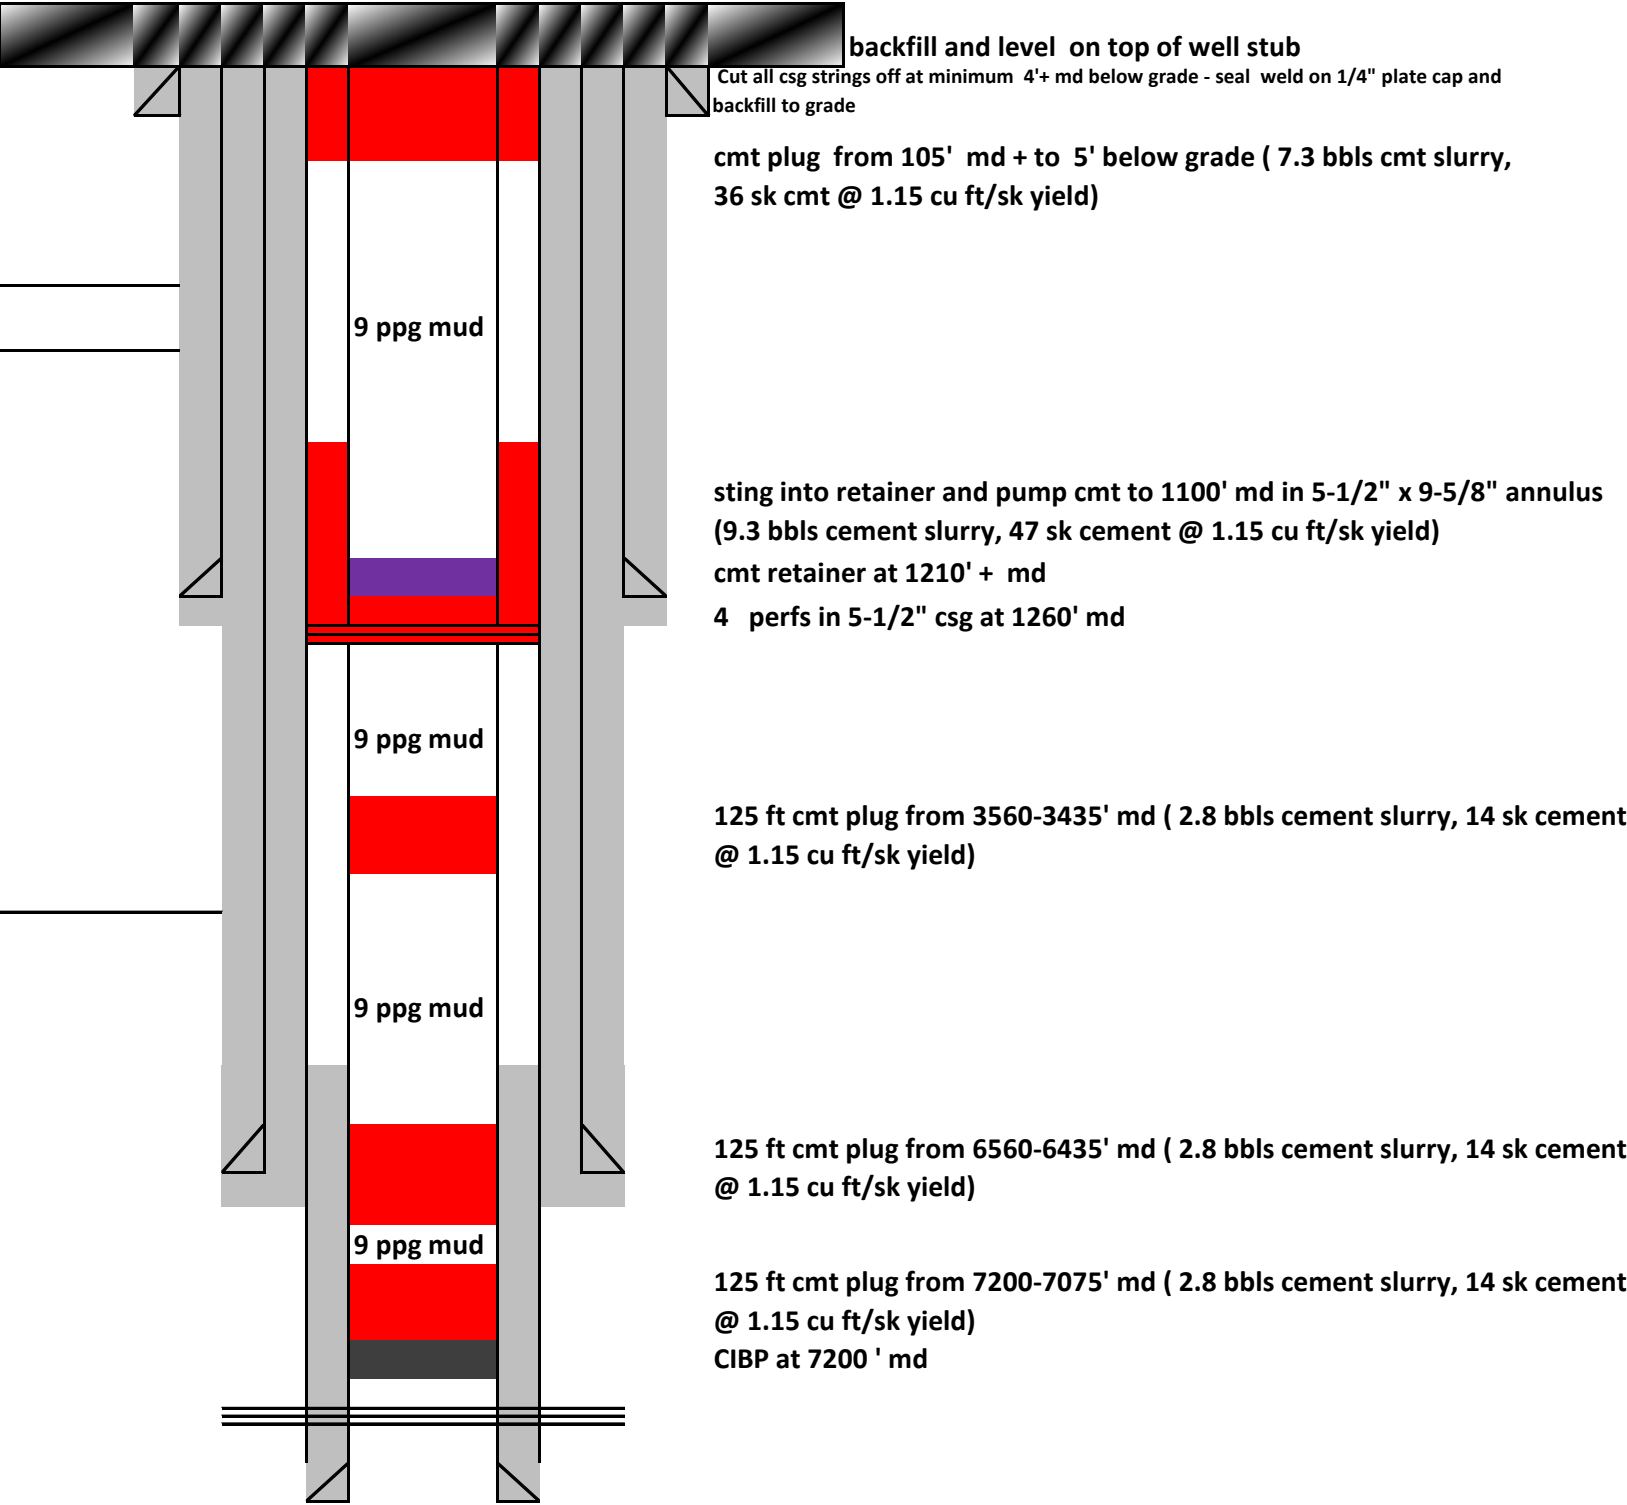

Red = min 15.8 ppg cmt, 4000 psi compressive strength in 24 hrs