WELLBORE SCHEMATIC

PROPOSED

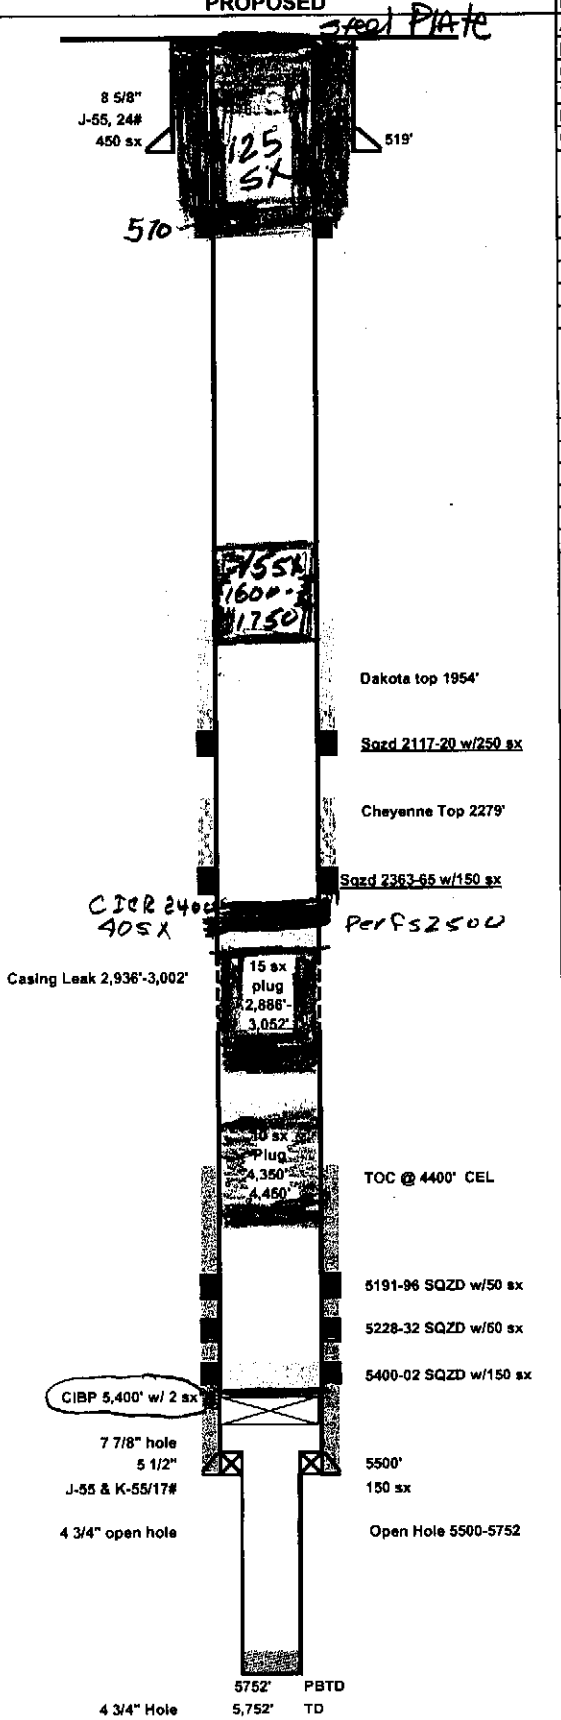

Citation Oil & Gas Corp.

Lease:	Chunky			Well No.	12-28 #1
API No.	05-017-07380			Status	SI
Location:	SW NW Sec 28 T13S R43W				
County:	Cheyenne	State:	CO	Field:	Mayfield
TD	5,752'	GL	4,092'	Spud Date:	11/201998
PBTD	5,752'	KB	4,105'	Comp Date:	12/4/98
Current Perfs/OH:				Current Zone:	Warsaw/Osage/St. Joe/Arbuckle

Surface Equipment

Unit Make:		Unit Size:	
Unit S/N:		Unit Rotation:	
SPM:	Stroke Length:	Unit Sheave:	
Prime Mover:		Motor Sheave:	
Motor S/N:		Motor RPM:	

Casing Breakdown

	Size	Grade / Wt	Depth	Cement
Surface	8 5/8"	J-55/24#	519'	450 sx
Production	5 1/2"	J-55 & K-55/17#	5500'	150 sx

Current Completion Assembly

Qty	Description	Footage
	TOTAL	0.00'

Rod Detail

Qty	Description	Footage
	TOTAL	0.00'

Comments

PREPARED BY:	LL	UPDATED:	7/25/2017