



Status: East, Ditch, Geology, Earthstar Geographics, CNES, Aerial, 2017, and the 2018 User Community

Meyring 13-27 Flowline

Author:

Printed: September 29, 2017

Legend

- Preliminary
- Existing
- Proposed
- Kick off Point
- Landing Point
- Bottom Hole
- Bore Path





Sources: Esri, HERE, DeLorme, USGS, Intermap, INCREMENT P, (Hong Kong), Esri Korea, Esri (Thailand), MapmyIndia, NGCC, GIS User Community

Legend

- Preliminary
- Existing
- Proposed
- Landing Point
- Kick off Point
- Bottom Hole
- Bore Path

Meyring 13-27 Flowline


Author:

Printed: September 29, 2017



MEYRING 13-27
WEST Dig Site
Flow Line LEAK

N

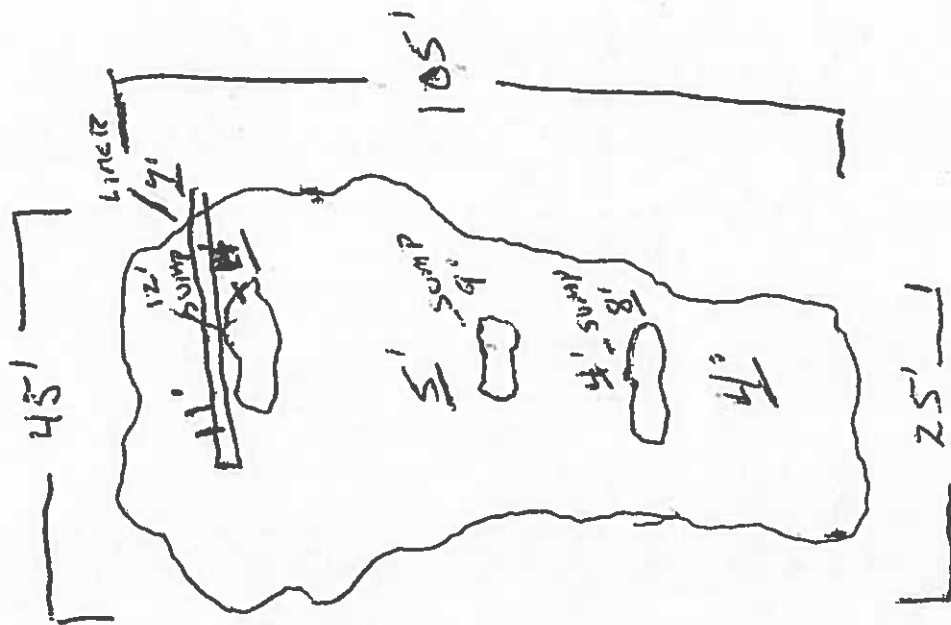

W

LINER 7' depth

NORTH Sump -

Flushing in oil
From north & south

CENTER DUMP -

Flushing in oil
From west & north

SOUTH Sump -
Cleared up.

E

TOTAL SOIL HAULED
TO DISPOSAL

1200 YARDS

TOTAL WATER
MOVED OUT

700 bbls.

As of 9/28

LAT - Long

NORTH & LINER - 40.54132 104.65488
CENTER - 40.54121 104.65491
SOUTH - 40.54109 104.65496


S

MEYRING 13-27

Flowline LEAK
East Dig Site

9128117

N

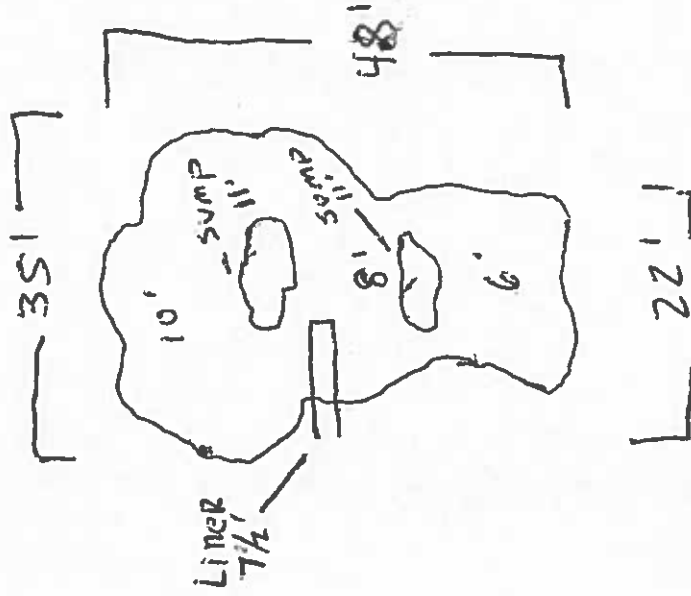

SOUTH SUMP
cleaned up

TOTAL WATER HAULED
& PUMPED.

350 bbls E

10 bbl oil

TOTAL SOIL HAULED

500 YARDS

As of 9128

LAT - Longs

NORTH - 40.54130 - 104.65421

Center
Liner - 40.54129 - 104.65415

SOUTH - 40.54119 - 104.65426