


Amoco Production Co.

Champlin 365 Amoco Unit A #2 - P&A Re-entry

API 05-123-10181

PLANNED WELLBORE DIAGRAM

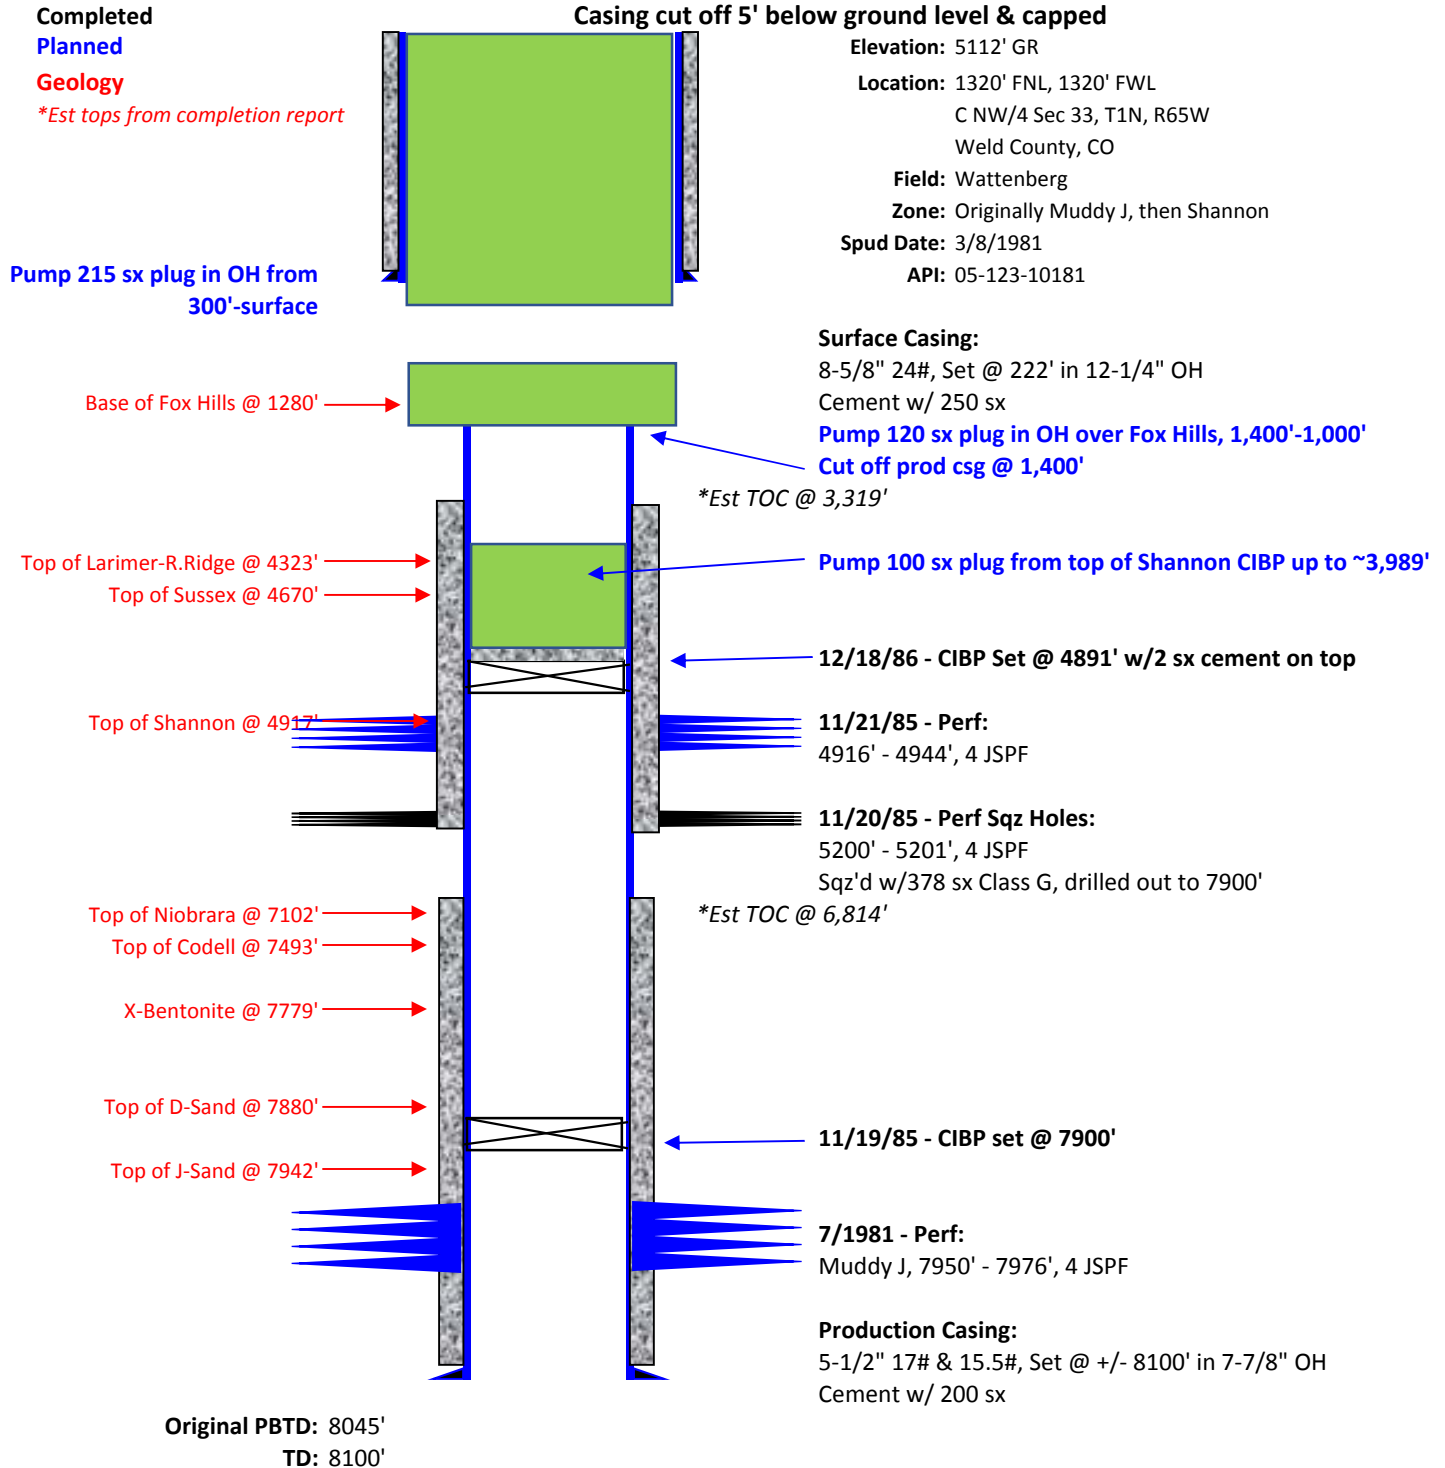

(Not to Scale)