

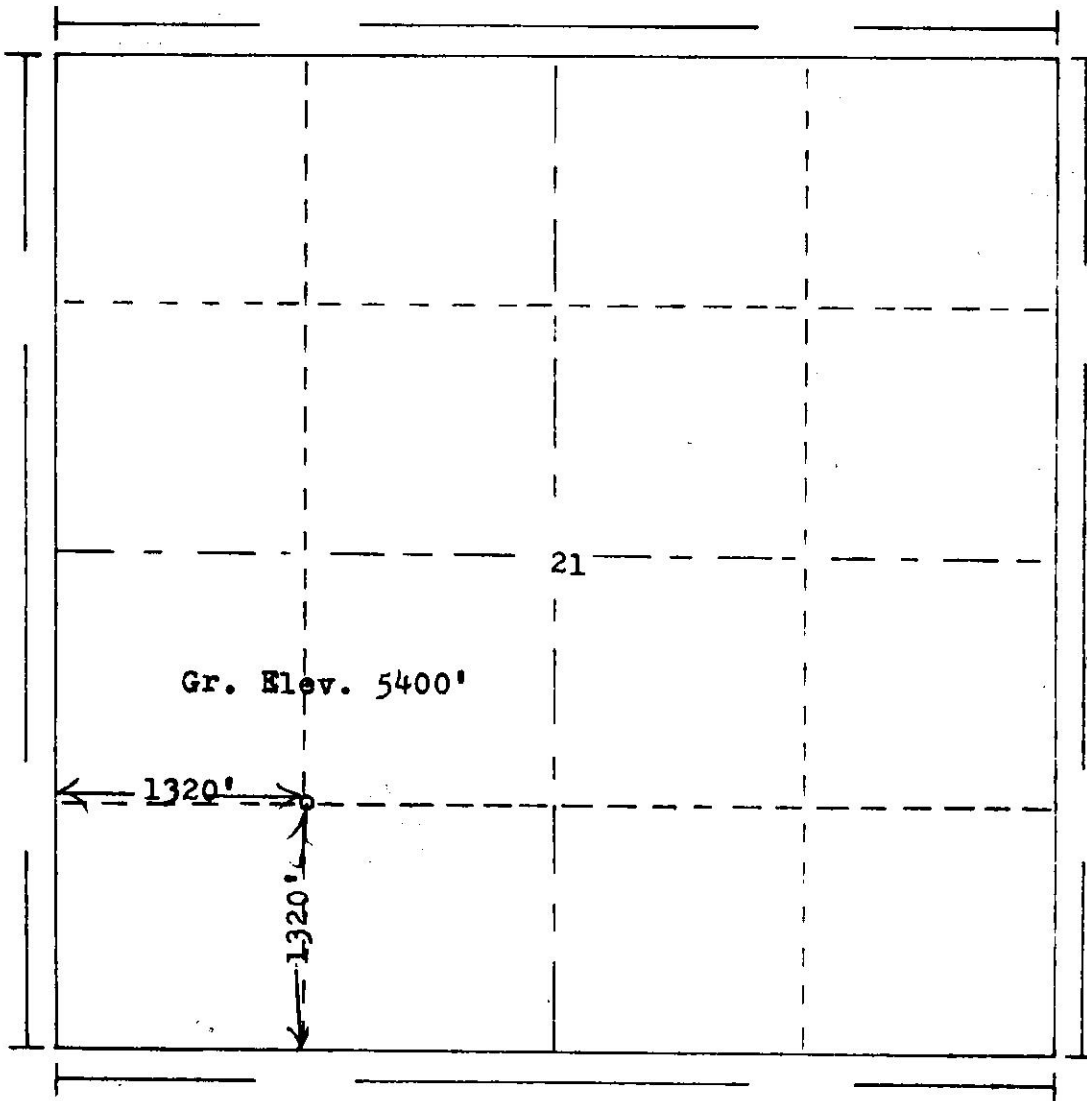


RECEIVED

MAY 18 1978

R. 65W

CO. 2

T.
2
S

Scale... 1" = 1000'

Powers Elevation Company, Inc. of Denver, Colorado
has in accordance with a request from Mr. Gelhefer
for Amoco Production Co.

determined the location of No. 125 Champlin-Amoco H-1
to be CSW $\frac{1}{2}$ Section 21 Township 2S
Range 65W of the 6th Principal Meridian
Adams County, Colorado

I hereby certify that this plat is an
accurate representation of a correct
survey showing the location of

Date: 5-12-78

R. J. H. H.
Licensed Land Surveyor No 2853
State of Colorado