

CERTIFICATE OF SURVEY
for
Allison Drilling Co.
Logan County, Colorado




Lower

RECEIVED
JAN 17 1966

OIL & GAS
CONSERVATION COMMISSION

T10N R53W 6PM

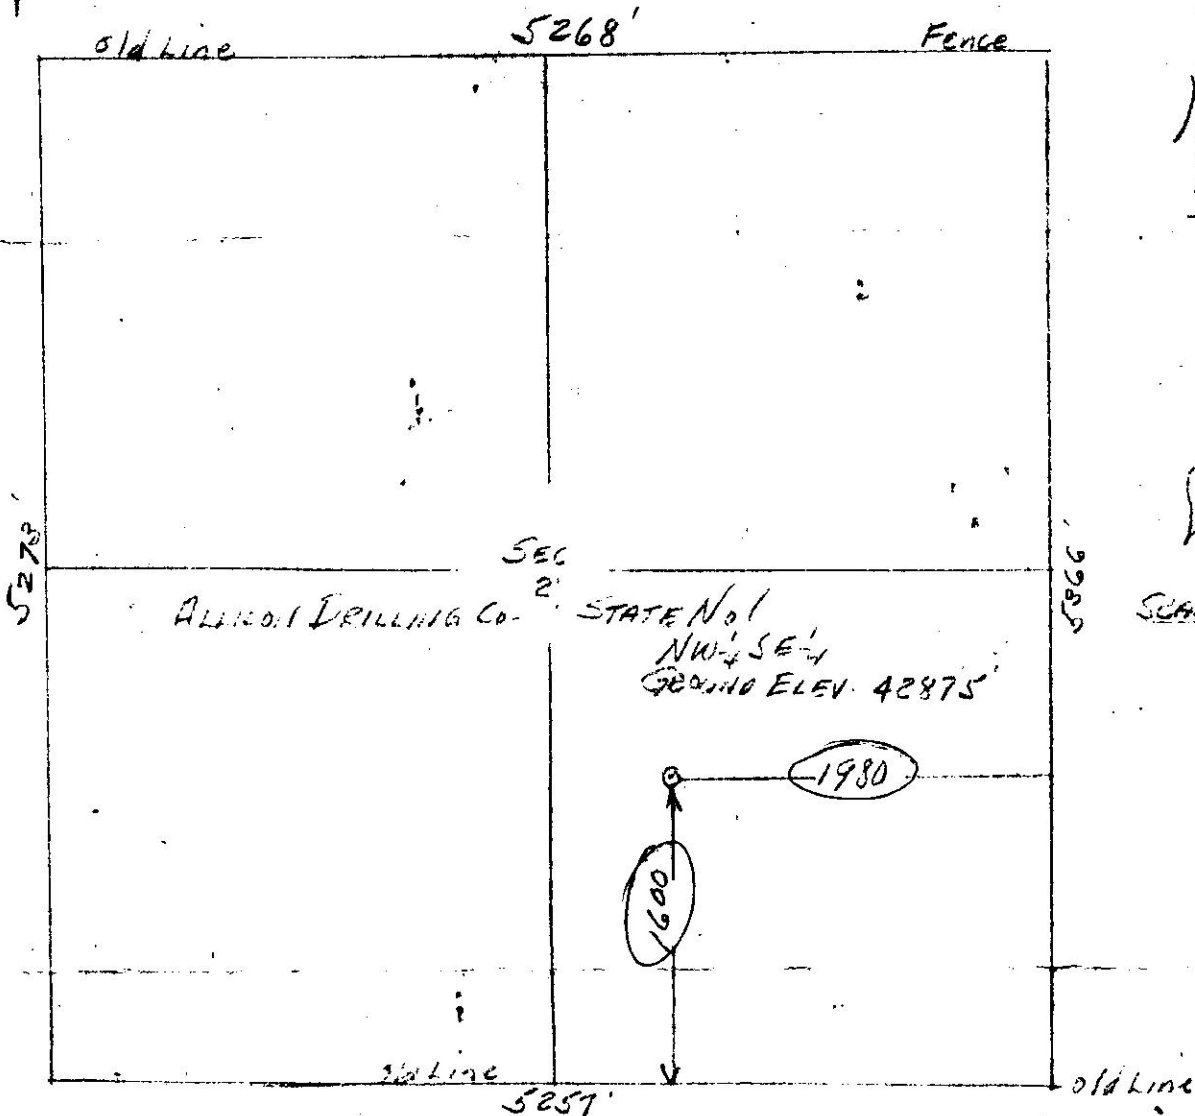

SCALE 1"=1000'

I hereby certify that the above plat is an accurate representation of a correct survey showing the location of Allison Drilling Co. - State No. 1 Oilwell in NW 1/4 SE 1/4 Sec. 2 T10N R53W 6PM. The elevation of the ground at the stake is 4287.5 feet above sea level from U.S.C.S. Bench Mark.

Fort Morgan, Colorado
Dec. 26, 1965

Ben J. Osborne
Registered Professional Engineer
State of Colorado

63 567

2-10N-53W
allison #1 state