

2-4-63

Well-data MEMO

Springdale Storage #3 (State B-2)

9184 K.B.

SEQ, 16-8N-53W
LOGAN Co, Colo.

Tight spot in
pipe 2777-2777.5 →

2777-83, found LANK, 6-2-63

Sprayed w/90 SAKS
No 59. parts.
Tested To 800 ft.


SET PULLER @ 2800
Driven To 4820

5'6", 14⁺, SS, 8mid, J-SS-NEW
100 SACKS, REG + 4% SEL

Multiply	By	To Obtain
Barrels	5.6146	Cubic Feet
Cubic Feet	7.4806	Gallons
Gallons	0.1337	Cubic Feet
Pounds / Gal.	7.4806	Lbs. / Cu. Ft.

0.00545 x I.D. in inches = Cu. Ft. / Ft.
0.0407 x I.D. in inches = Gals. / Ft.
0.00097 x I.D. in inches = Bbls. / Ft.

For Water:
 $0.434 \times \text{Depth in feet} = \text{lbs./sq. in.}$
 For Mud:
 $0.00695 \times \text{Depth} \times \text{Mud Weight (lbs./cu. ft.)} = \text{lbs./sq. in.}$
 For Oil:
 $0.434 \times \text{Depth} \times \text{Sp. Gr.} = \text{lbs./sq. in.}$

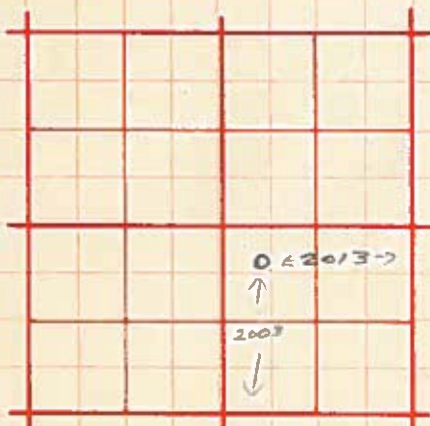

Sec. 16 Twp 8N R. 53W

Blk. _____ Sec. _____ Sur _____

PIPE SET

4933'

THIS **MEMO** SHEET COMPLIMENTS OF

DOWELL