


Well Name: MONFORT GILCREST K16-08

VERTICAL - ORIGINAL HOLE, 10/24/2017 4:42:21 PM

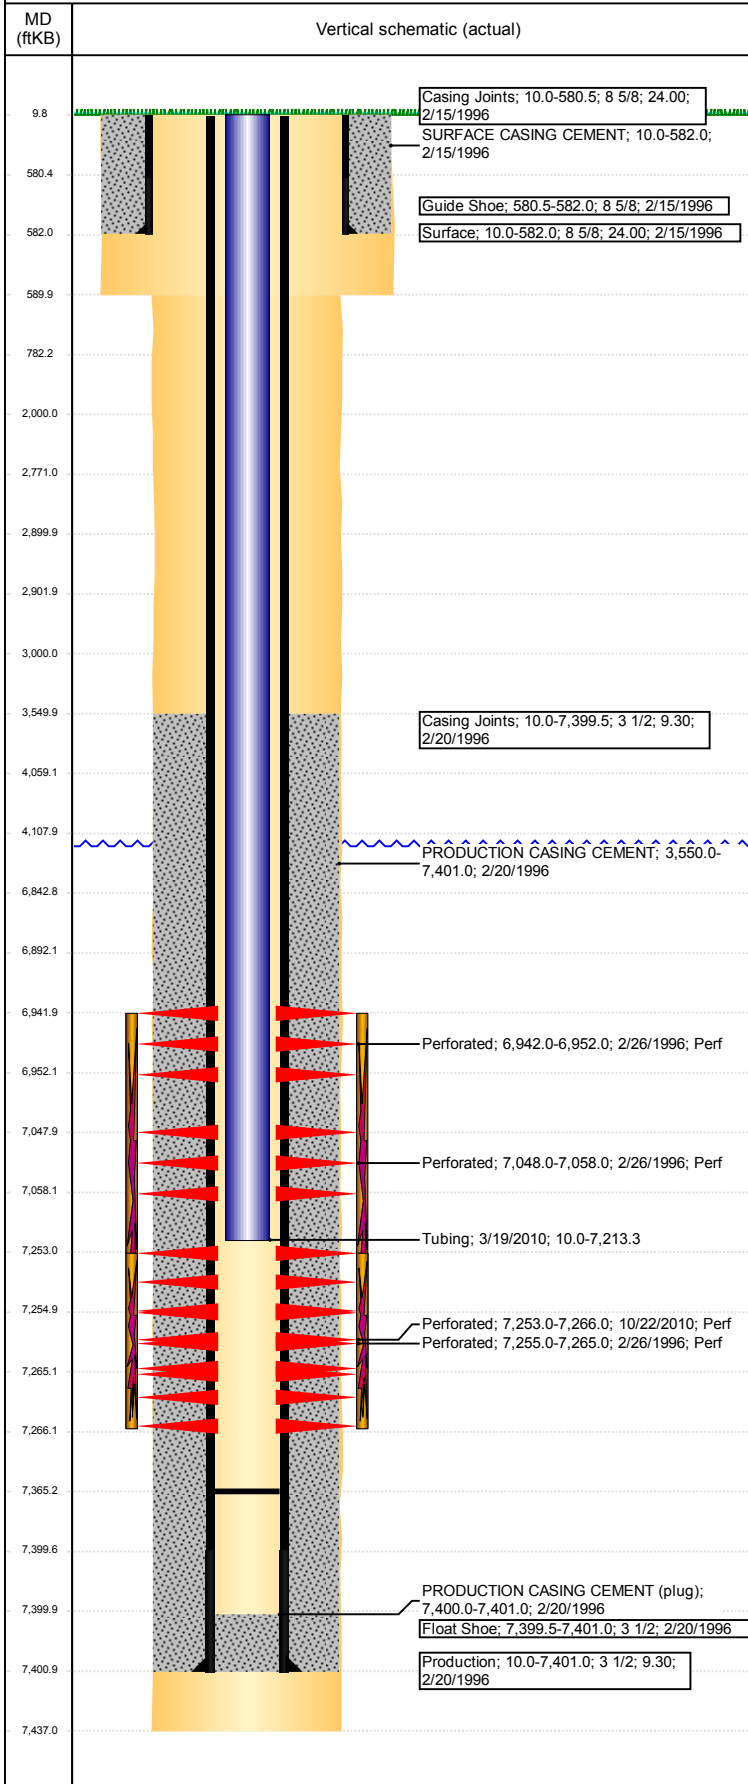

Well Header

| | | |
|--|------------------------------------|---------------------------------------|
| API 05-123-18993 | Well Report Center 425734340 | Well Configuration Type VERTICAL |
| Original KB Elevation (ft) 4,747 | KB - GL / MSL (ftKB) 10.00 | Spud Date 2/15/1996 |
| Production Route Watt - A1-08 | Well Production Status PR | SoRT Ignore No |
| Directions To Well RD 31 & RD 46, WEST 1/10, SOUTH THROUGH BATTERY 3/8 INTO. | Actual Latitude (°) 40.31350870 | Actual Longitude (°) -104.77558507 |
| Comment THIS WELL ACQUIRED FROM MONFORT 4/2009. ALL DATA PULLED FROM THE COGCC WEBSITE. | | |

Congressional Location

| | | | | | | |
|-----------------|-----------------|---------------|---------------|---------------------|-------------|--------------------|
| Quarter 3 SE | Quarter 4 NE | Section 16 | Township 4 | Twnshp N/S Dir N | Range 66 | Range E/W Dir W |
|-----------------|-----------------|---------------|---------------|---------------------|-------------|--------------------|

Plug Back Total Depths

| Date | Depth (ftKB) | Method | Com |
|------------|--------------|-----------|-----|
| 11/19/2010 | 7,365.0 | TBG TALLY | TAG |

Wellbore Sections

| Section Des | Size (in) | Act Top, MD (ftKB) | Act Btm, MD (ftKB) |
|-------------|-----------|--------------------|--------------------|
| SURFACE | 12 1/4 | 10 | 590 |
| PRODUCTION | 7 7/8 | 590 | 7,437 |

Zone Statuses

| Zone Name | Status Date | Status |
|-----------|-------------|--------|
| CODELL | 11/16/2010 | PR |
| NIOBRARA | 3/22/1996 | PR |

Casing Strings

Surface, 582.0ftKB

| Casing Description | Run Date | OD (in) | Wt/Len (l...) | Grade | Top, MD (ft...) | MD (ftKB) |
|--------------------|-----------|---------|---------------|-------|-----------------|-----------|
| Surface | 2/15/1996 | 8 5/8 | 24.00 | | 10.0 | 582.0 |

Production, 7,401.0ftKB

| Casing Description | Run Date | OD (in) | Wt/Len (l...) | Grade | Top, MD (ft...) | MD (ftKB) |
|--------------------|-----------|---------|---------------|-------|-----------------|-----------|
| Production | 2/20/1996 | 3 1/2 | 9.30 | | 10.0 | 7,401.0 |

Cement

| Des | Start Date | Top (ftKB) | Btm (ftKB) |
|--------------------------|------------|------------|------------|
| SURFACE CASING CEMENT | 2/15/1996 | 10.0 | 582.0 |
| PRODUCTION CASING CEMENT | 2/20/1996 | 3,550.0 | 7,401.0 |

Proposed Cement

| Des | Top (ftKB) | Btm (ftKB) |
|-----------------------|------------|------------|
| PA Plug - Below CICR | 2,902.0 | 3,000.0 |
| PA Plug - Top of CICR | 2,771.0 | 2,900.0 |
| Shoe Plug | 10.0 | 782.0 |
| PA Plug - Annulus | 2,000.0 | 3,000.0 |

Tubing Strings

| Tubing Description | Run Date | String... | ID (in) | Wt (lb/ft) | Grade | Len (ft) | Set De... |
|----------------------|-----------|-----------|---------|------------|-------|----------|-----------|
| Tubing - Frac string | 11/8/2010 | 2 3/8 | 2.00 | 4.70 | N-80 | 7,108.15 | |

Tubing Components

| Item Des | OD (in) | Wt (lb/ft) | Grade | Jts | Len (ft) | Btm (ftKB) | Btm (TVD) (ftKB) |
|------------|---------|------------|-------|-----|----------|------------|------------------|
| Tubing | 2 3/8 | 4.70 | N-80 | 219 | 6,787.62 | 6,787.6 | |
| Cross Over | 2 1/16 | 4.70 | N-80 | 1 | 1.00 | 6,788.6 | |
| Tubing | 2 1/16 | 3.25 | N-80 | 10 | 314.53 | 7,103.2 | |
| Packer | 2 | 4.70 | N-80 | 1 | 5.00 | 7,108.2 | |

Other In Hole

| Run Date | Des | OD (in) | Top (ftKB) | Btm (ftKB) |
|----------|-----|---------|------------|------------|
| | | | | |

Proposed Other In Hole


| Des | OD (in) | Top (ftKB) | Btm (ftKB) |
|--------------------------------------|---------|------------|------------|
| Cement Retainer | 3 | 2,900.0 | 2,902.0 |
| Cast Iron Bridge Plug w/ 2 SX Cement | 3 | 6,843.0 | 6,892.0 |
| Cast Iron Bridge Plug w/ 2 SX Cement | 3 | 4,059.0 | 4,108.0 |

Logs

| Date | Type | Top, MD (ftKB) | Btm, MD (ftKB) |
|-----------|---------------------|----------------|----------------|
| 2/20/1996 | COMPENSATED DENSITY | 4,100.0 | 7,397.0 |
| 2/20/1996 | INDUCTION | 582.0 | 7,421.0 |

Well Name: MONFORT GILCREST K16-08

VERTICAL - ORIGINAL HOLE, 10/24/2017 4:42:22 PM

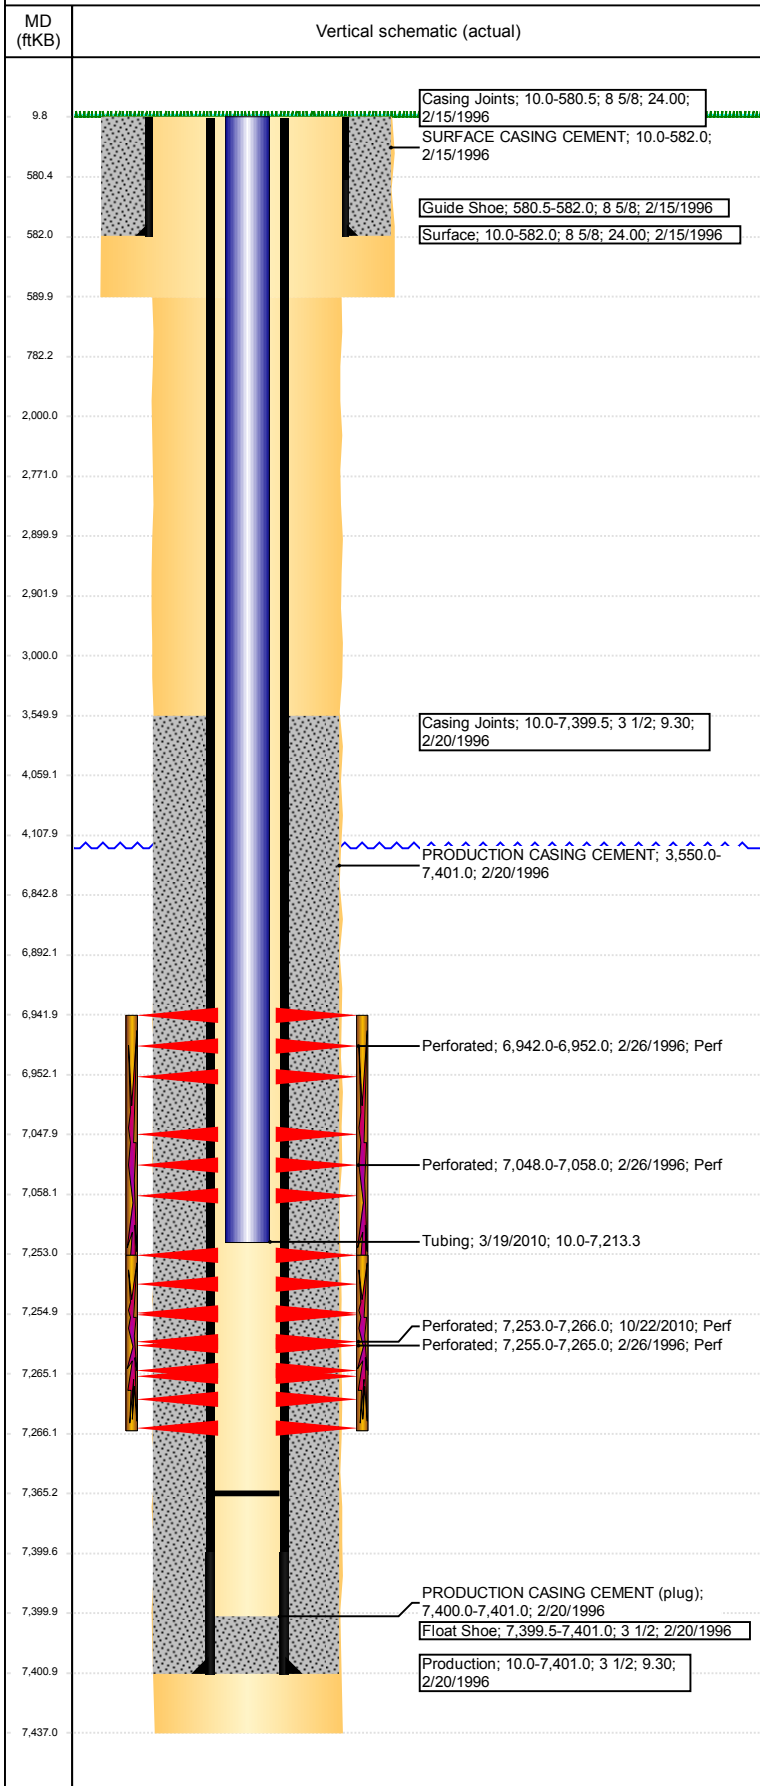

| Logs | | | |
|-----------|-------------|----------------|----------------|
| Date | Type | Top, MD (ftKB) | Btm, MD (ftKB) |
| 2/26/1996 | CEMENT BOND | 3,400.0 | 7,342.0 |

| Perforation Data | | | | |
|-------------------------|---------------------------|------------|------------|------------|
| Linked Zone | Sum of Entered Shot Total | Top (ftKB) | Btm (ftKB) | Date |
| NIOBRARA, ORIGINAL HOLE | 7 | 6,942.00 | 6,952.00 | 2/26/1996 |
| NIOBRARA, ORIGINAL HOLE | 7 | 7,048.00 | 7,058.00 | 2/26/1996 |
| CODELL, ORIGINAL HOLE | 52 | 7,253.00 | 7,266.00 | 10/22/2010 |
| CODELL, ORIGINAL HOLE | 6 | 7,255.00 | 7,265.00 | 2/26/1996 |
| Total (Sum) | 72 | | | |

| Proposed Perforations | | | | |
|-----------------------|--------------|------------------|------------|------------|
| Linked Zone | Sum of En... | Top Depth (ftKB) | Btm (ftKB) | Date |
| | 0 | 3,000.00 | 3,000.00 | 10/24/2017 |
| Total (Sum) | 0 | | | |