



00116769


CERTIFICATE OF SURVEY
for
C.W.I. Oil and Gas Co.
Weld County, Colorado

RECEIVED

APR 06 1983

COLO. OIL & GAS CONS. COMM.

T4N R66W 6PM.

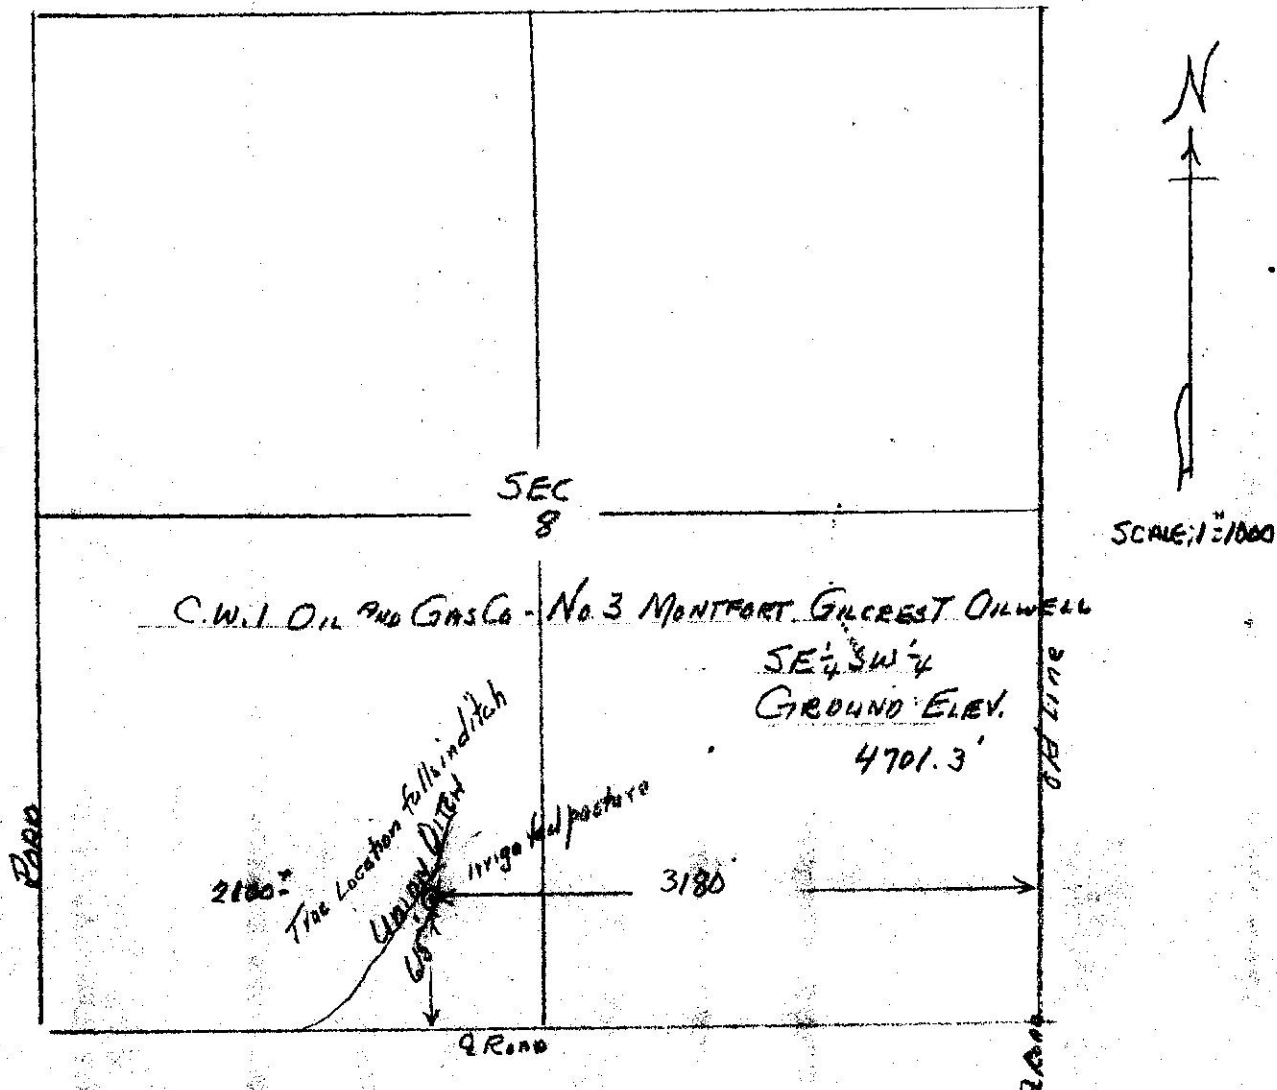

I hereby certify that the above plat is an accurate representation of a correct survey showing the location of C.W.I. Oil and Gas Co.-No.3 Montfort-Gilcrest Oilwell in SE 1/4 SW 1/4 Sec.8 T4N R66W 6PM. The elevation of the ground at the stake is 4701.3 feet above sea level from U.S.G.S. Bench Mark.

Fort Morgan, Colorado
March 30, 1983

Laecil J. Robinson
Registered Professional Engineer
State of Colorado

BEST COPY
AVAILABLE