

Wait offset
638' away

STATE AF 1
05-123-05368


DWR
26'

10 3/4"
@ 377' w/ ~~100~~ 5x
170

25 5x @ 40 to surface
25 5x @ 377' up

SWX TOP: 4230'

NW TOP: 6842'

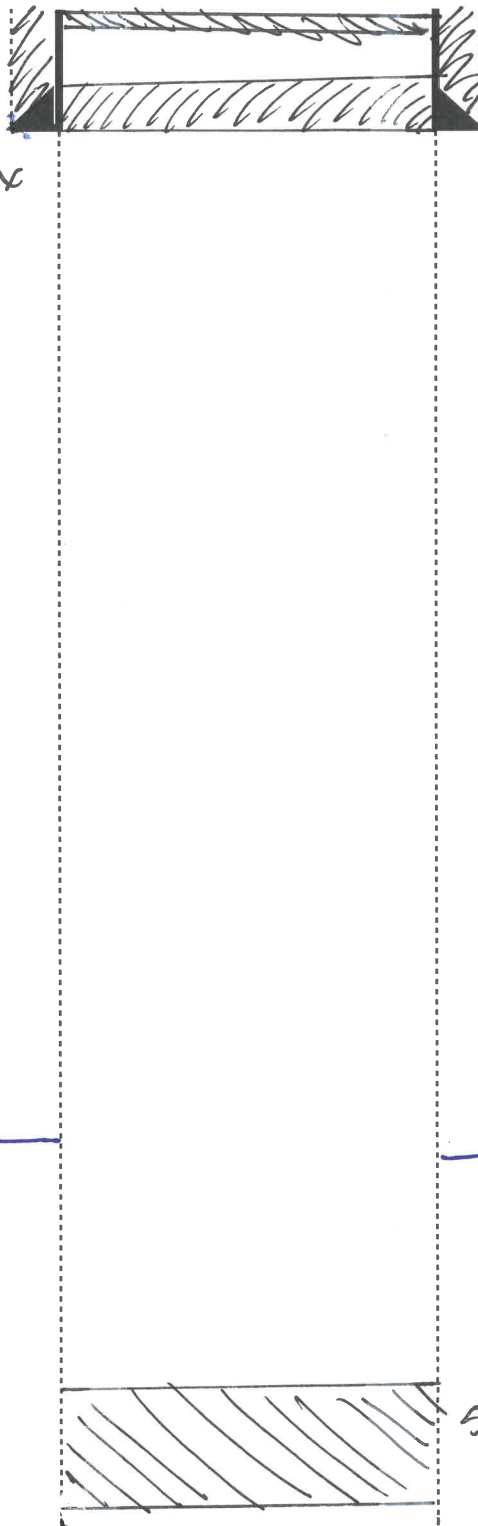

TD: 9060'

Remediation Recommended
~~NEED TO REMEDIATE~~
~~No remediation required~~
~~AD @ 377' up~~