FRANE SURVEYING INC.

Physical Address: 34834 Annie Cir.
Mail to: Box 2372, Elizabeth, CO 80107
Ph. 303-243-0037
www.franesurveying.com

Job # 17-012-Rogue 10-25

Frane Surveying, in accordance with a request from **Murfin Drilling Company, Inc.** has determined the location of **Rogue #10-25** to be **2367 feet FSL,** and **1804 feet FEL**, (90° off Section lines) **of** SECTION **25,** Township **9s**, Range **56w** of the 6th Principal Meridian, **Lincoln County**, Colorado.

Date: Staked on 04/27/17 drawn on 05/01/17.

Re: Staked by Elijah Frane
Drawn: Drawn by Elijah Frane

COLORADO LICENSED ELIJAH FRANE 38376 PROFESSIONAL LAND SURVEYOR 5/2/17

Basis of Elevation Spot: USGS BM = E 25, PID = KJ0219, H-Order = First, V-Order = First, Stability = C, US NAD 83 CO-C, Lat. = 39.21461, Long. = W103.60209, Elevation =5248.17'

Notes: See location drawing for improvements within 500' of proposed well pad / head..
The ground elevation at staked location = 5298.63' gr.
This drawing does not represent a monumented survey or Land Survey Plat.
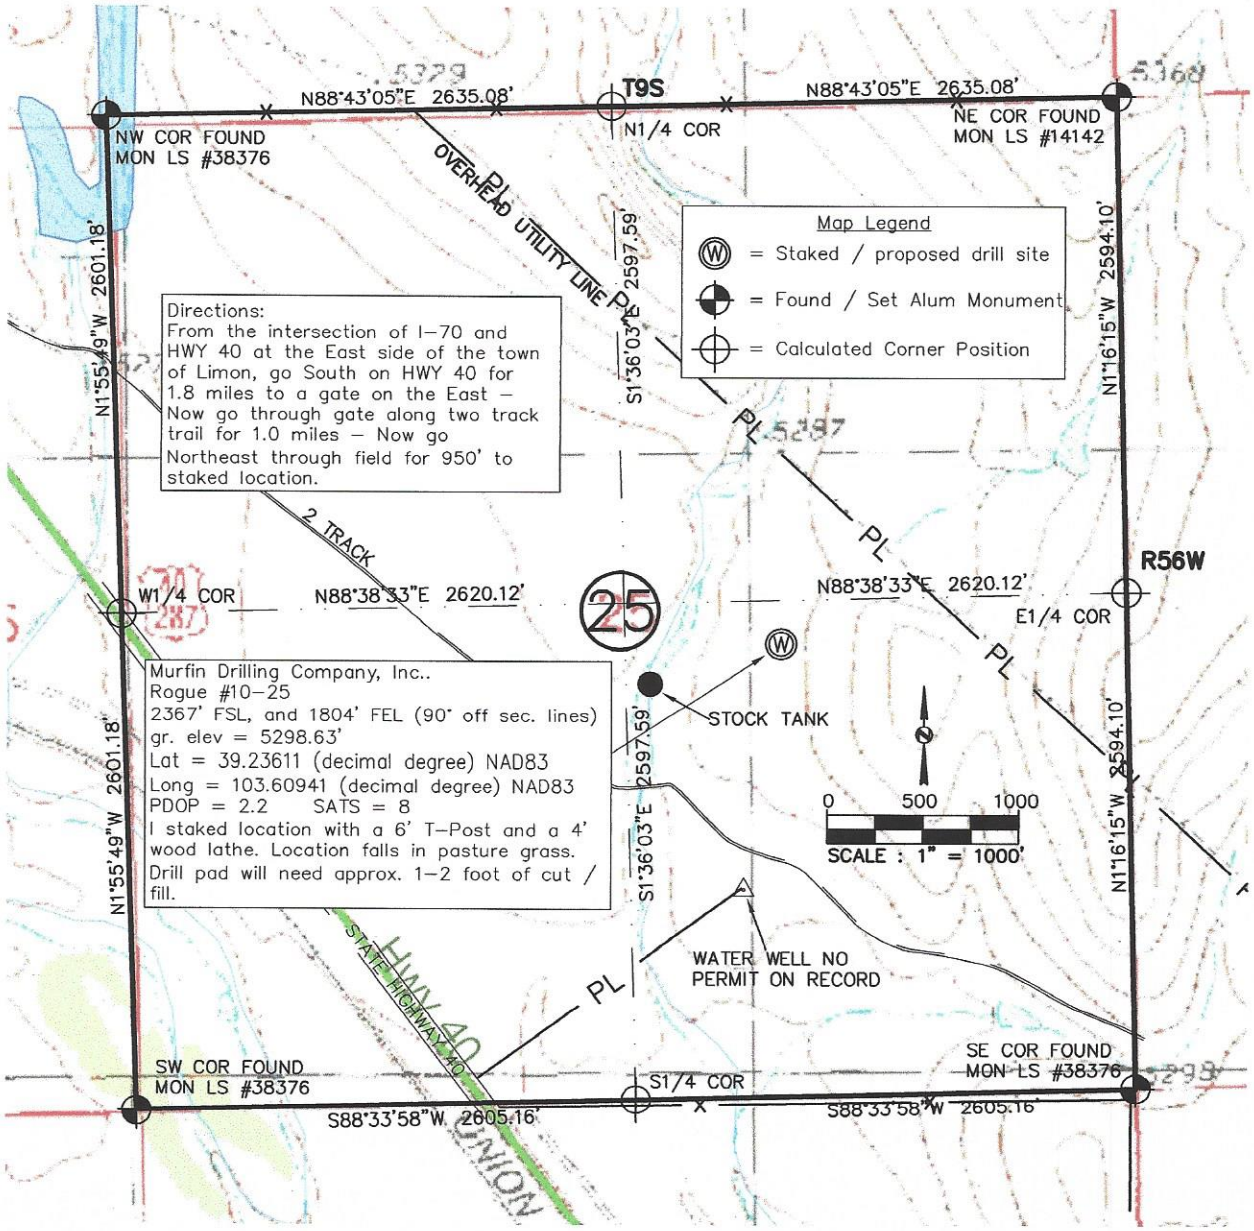
Basis of Bearing: Bearings were determined based on the North line of Section 30 to bear N88°43'05"E with all other bearings contained herein relative thereto.