


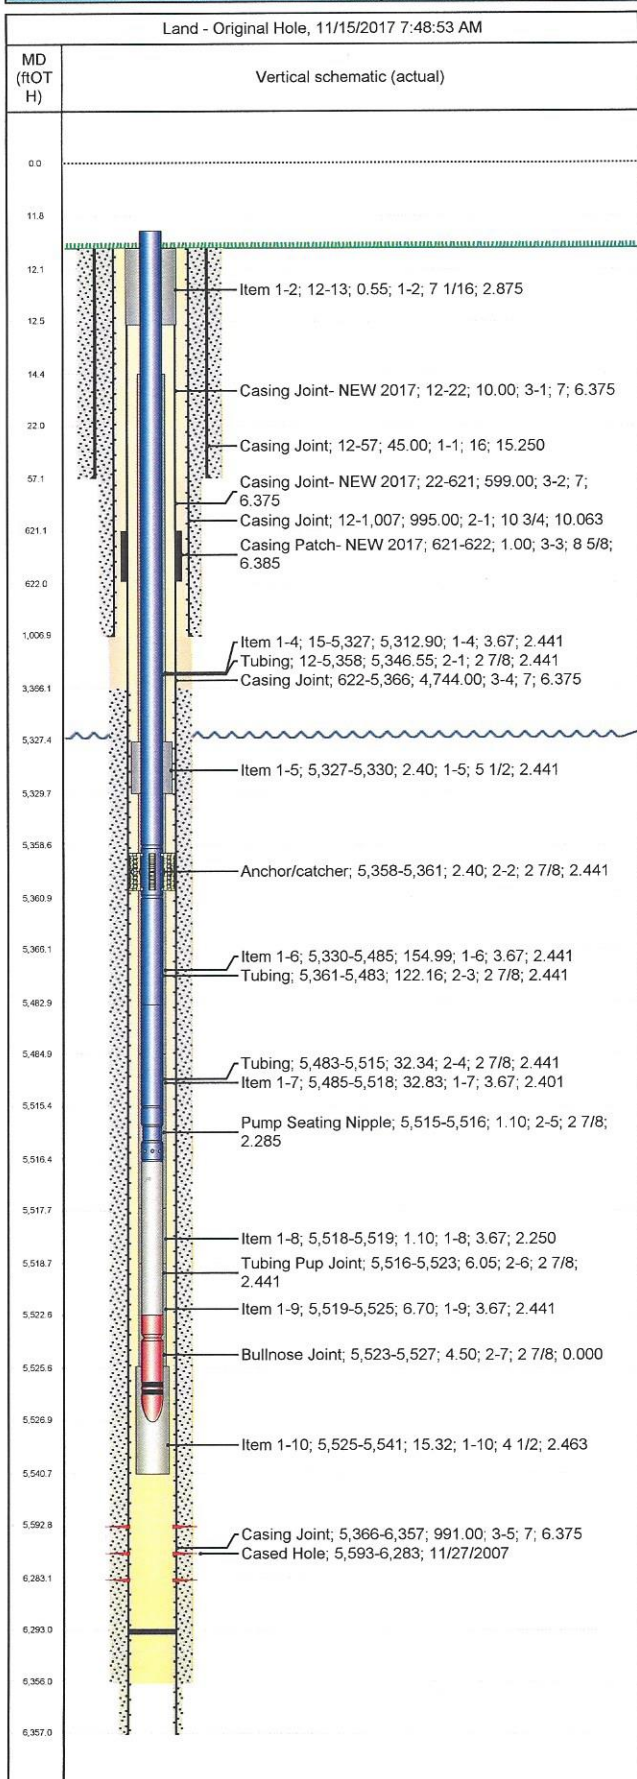

Wellbore Schematic

| | | | |
|---------------------------------|--------------------------|-----------------------|--------------------------------|
| Well Name Rector Everett 09X | Lease Rector, Everett | Field Name Rangely | Business Unit Mid-Continent |
|---------------------------------|--------------------------|-----------------------|--------------------------------|



Job Details

| | | |
|----------------------------|------------|-------------------|
| Job Category | Start Date | Rig/Unit End Date |
| Major Rig Work Over (MRWO) | 10/31/2017 | |

Casing Strings

| Csg Des | OD (in) | Wt/Len (lb/ft) | Grade | Top Thread | Set Depth (MD) (ftOTH) |
|-------------------|---------|----------------|-------|------------|------------------------|
| Conductor | 16 | 65.00 | H-40 | | 57 |
| Surface | 10 3/4 | 40.50 | J-55 | | 1,007 |
| Production Casing | 7 | 23.00 | J-55 | | 6,357 |

Tubing Strings

LONG TUBING set at 5,540.8ftOTH on 11/29/2007 00:00

| Tubing Description | | Run Date | String Length (ft) | Set Depth (MD) (ftO | | |
|--------------------|-----|------------|--------------------|---------------------|----------|-------------|
| LONG TUBING | | 11/29/2007 | 5,540.79 | 5,540.8 | | |
| Item Des | Jts | OD (in) | Wt (lb/ft) | Grade | Len (ft) | Btm (ftOTH) |
| | | 0.0 | 0.00 | 0 | 12.00 | 12.0 |
| | | 7 1/16 | 0.00 | 0 | 0.55 | 12.6 |
| | | 0.0 | 0.00 | 0 | 2.00 | 14.6 |
| | 172 | 3.668 | 6.50 | J-55 | 5,312.90 | 5,327.5 |
| | | 5 1/2 | 0.00 | 0 | 2.40 | 5,329.9 |
| | 5 | 3.668 | 6.50 | J-55 | 154.99 | 5,484.8 |
| | 1 | 3.668 | 6.50 | J-55 | 32.83 | 5,517.7 |
| | | 3.668 | 0.00 | 0 | 1.10 | 5,518.8 |
| | | 3.668 | 6.50 | J-55 | 6.70 | 5,525.5 |
| | | 4 1/2 | 0.00 | 0 | 15.32 | 5,540.8 |
| | | 0.0 | 0.00 | 0 | 0.00 | 5,540.8 |

Tubing set at 5,527.0ftOTH on 11/13/2017 17:00

| | | | | | | | |
|---------------------|--|------------|---------|--------------------|-------|----------------------|-------------|
| Tubing Description | | Run Date | | String Length (ft) | | Set Depth (MD) (ftO. | |
| Tubing | | 11/13/2017 | | 5,515.10 | | 5,527.0 | |
| Item Des | | Jts | OD (in) | Wt (lb/ft) | Grade | Len (ft) | Btm (ftOTH) |
| Tubing | | 172 | 2 7/8 | 6.40 | J-55 | 5,346.55 | 5,358.5 |
| Anchor/catcher | | 1 | 2 7/8 | | | 2.40 | 5,360.9 |
| Tubing | | 4 | 2 7/8 | 6.50 | J-55 | 122.16 | 5,483.0 |
| Tubing | | 1 | 2 7/8 | 6.50 | J-55 | 32.34 | 5,515.4 |
| Pump Seating Nipple | | 1 | 2 7/8 | | | 1.10 | 5,516.5 |
| Tubing Pup Joint | | 1 | 2 7/8 | 6.50 | J-55 | 6.05 | 5,522.5 |
| Bullnose Joint | | 1 | 2 7/8 | 6.50 | J-55 | 4.50 | 5,527.0 |

Perforations

| Date | Top (ftOTH) | Btm (ftOTH) | Shot Dens (shots/ft) | Entered Shot Total | Linked Zone |
|------------|-------------|-------------|----------------------|--------------------|-------------|
| 11/27/2007 | 5,593.0 | 6,283.0 | | | |

Other Strings

| Run Date | Pull Date | Set Depth (ftOTH) | Com |
|----------|-----------|-------------------|-----|
| | | | |

Other In Hole

| Des | Top (ftOTH) | Btm (ftOTH) | Run Date | Pull Date | Com |
|---------------------------|-------------|-------------|-----------|-----------|----------------------------------|
| Sand | 2,193.0 | 2,205.0 | 11/4/2017 | 11/8/2017 | 3 sacks |
| Bridge Plug (retrievable) | 2,205.0 | 2,211.0 | 11/4/2017 | 11/8/2017 | Tested to 500 psi for 15 minutes |
| Bridge Plug (retrievable) | 5,560.0 | 5,566.0 | 11/3/2017 | 11/7/2017 | Tested to 500 psi for 15 minutes |