



Holloway & Holloway, Inc.
 P.O. Box 3331
 Greeley, CO 80633
 (303) 867-3715
 (303) 352-5852

RECEIVED




SEP 28 01

basis of elev spot ele
 at NE cor. 4798'
 NE cor. re-bar
 in roadway

R67W

N

NW cor. fence
 corner S&W

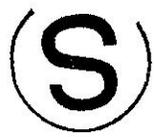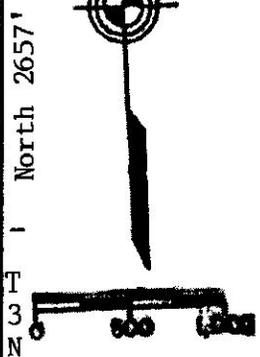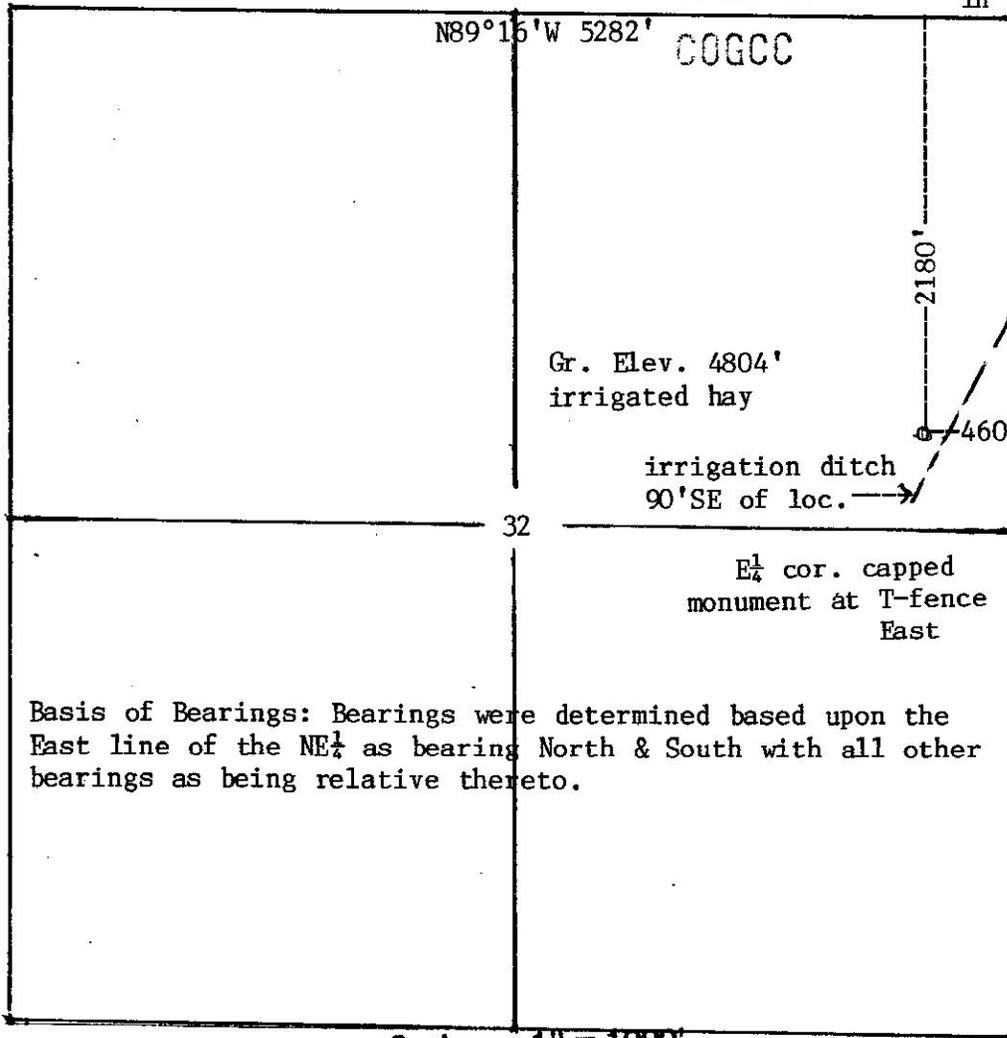

123-20604

In accordance with a request from H.S. Resources, Inc.
 the Undersigned has determined the location of the HSR-Heintzelman 8-32 well
 to be 2180'FNL & 460'FEL at right angles as co-ordinates
 Section 32 Township 3N Range 67W of the 6th principal Meridian
 Weld County, Colorado.

I hereby certify
 that this oil and/or gas well location certificate was prepared for H.S. Resources, Inc.
 that it is not a land survey plat or improvement survey plat, and that it is not to be relied upon for the
 establishment of fence, building or other future improvement lines

Date 8-27-2001

Ricky L. Holloway
 Holloway & Holloway, Inc.
 States of
 Colorado, Nebraska, Wyoming

