



Directional Survey Certification

2948 I-70 Business Loop
Grand Junction, CO 81504
(970)-245-9447 Fax (970)-245-9454

Operator	TEP Rocky Mountain, LLC.
Well Name & No.	SR 41-12
County & State	Garfield County, CO
SDI Job No.	OP.002575 & OP.003401
Rig	H&P 318

I, Mel Mireles Jr., having personal knowledge of all the facts, hereby certify that the attached directional survey run from a measured depth of 125 feet to a measured depth of 9,883 feet is true and correct as determined from all available records.


Signature

14-Aug-17
Date

Mel Mireles Jr.
Grand Junction Assistant Well Planner
Scientific Drilling - Colorado District

Company:	TEP Rocky Mountain LLC	Local Co-ordinate Reference:	Well SR 41-12 - Slot B7
Project:	Garfield County, CO NAD83	TVD Reference:	GL 7254' & RKB 24' @ 7278.00usft (H&P 318)
Site:	RU 32-12 Pad	MD Reference:	GL 7254' & RKB 24' @ 7278.00usft (H&P 318)
Well:	SR 41-12	North Reference:	True
Wellbore:	OH	Survey Calculation Method:	Minimum Curvature
Design:	OH	Database:	Grand Junction District

Project	Garfield County, CO NAD83		
Map System:	US State Plane 1983	System Datum:	Mean Sea Level
Geo Datum:	North American Datum 1983		
Map Zone:	Colorado Central Zone		

Site		RU 32-12 Pad			
Site Position:		Northing:	1,599,253.30 usft	Latitude:	39.4554808
From:	Map	Easting:	2,341,050.00 usft	Longitude:	-107.8339555
Position Uncertainty:	0.00 usft	Slot Radius:	13.20 in	Grid Convergence:	-1.47 °

Well		SR 41-12 - Slot B7				
Well Position	+N/-S	0.00 usft	Northing:	1,599,211.80 usft	Latitude:	39.4553683
	+E/-W	0.00 usft	Easting:	2,341,070.00 usft	Longitude:	-107.8338809
Position Uncertainty		0.00 usft	Wellhead Elevation:	0.00 usft	Ground Level:	7,254.00 usft

Wellbore	OH				
Magnetics	Model Name	Sample Date	Declination (°)	Dip Angle (°)	Field Strength (nT)
	HDGM	8/8/2017	9.25	65.67	51,681

Design	OH				
Audit Notes:					
Version:	1.0	Phase:	ACTUAL	Tie On Depth:	0.00
Vertical Section:	Depth From (TVD) (usft)	+N/-S (usft)	+E/-W (usft)	Direction (°)	
	0.00	0.00	0.00	38.34	

Survey Program	Date	8/14/2017			
From (usft)	To (usft)	Survey (Wellbore)	Tool Name	Description	
125.00	678.00	Survey #1 - Gyro MWD Survey (OH)	SDI Gyro MWD 104	SDI Gyro MWD Error Model Ver 1.0.4	
752.00	1,164.00	Survey #2 - Surface MWD Survey (OH)	SDI MWD	SDI MWD - Standard ver 1.0.1	
1,274.00	9,883.00	Survey #3 - Production MWD Survey (OH)	SDI MWD	SDI MWD - Standard ver 1.0.1	

Survey										
Measured Depth (usft)	Inclination (°)	Azimuth (°)	Vertical Depth (usft)	+N/-S (usft)	+E/-W (usft)	Vertical Section (usft)	Dogleg Rate (°/100usft)	Build Rate (°/100usft)	Turn Rate (°/100usft)	
0.00	0.00	0.00	0.00	0.00	0.00	0.00	0.00	0.00	0.00	
125.00	0.35	353.50	125.00	0.38	-0.04	0.27	0.28	0.28	0.00	
First SDI Gyro MWD Survey										
217.00	2.99	34.45	216.95	2.64	1.28	2.86	2.97	2.87	44.51	
309.00	6.60	34.10	308.62	9.00	5.61	10.53	3.92	3.92	-0.38	
401.00	9.85	38.94	399.66	19.50	13.52	23.68	3.61	3.53	5.26	
494.00	12.76	38.32	490.84	33.75	24.89	41.91	3.13	3.13	-0.67	
586.00	15.04	40.78	580.15	50.76	38.99	64.00	2.56	2.48	2.67	
678.00	16.80	39.11	668.61	70.12	55.17	89.22	1.98	1.91	-1.82	

Company:	TEP Rocky Mountain LLC	Local Co-ordinate Reference:	Well SR 41-12 - Slot B7
Project:	Garfield County, CO NAD83	TVD Reference:	GL 7254' & RKB 24' @ 7278.00usft (H&P 318)
Site:	RU 32-12 Pad	MD Reference:	GL 7254' & RKB 24' @ 7278.00usft (H&P 318)
Well:	SR 41-12	North Reference:	True
Wellbore:	OH	Survey Calculation Method:	Minimum Curvature
Design:	OH	Database:	Grand Junction District

Survey									
Measured Depth (usft)	Inclination (°)	Azimuth (°)	Vertical Depth (usft)	+N/-S (usft)	+E/-W (usft)	Vertical Section (usft)	Dogleg Rate (°/100usft)	Build Rate (°/100usft)	Turn Rate (°/100usft)
Last SDI Gyro MWD Survey									
752.00	19.09	39.84	739.01	87.71	69.67	112.01	3.11	3.09	0.99
First SDI Surface MWD Survey									
847.00	21.45	38.51	828.12	113.23	90.44	144.92	2.53	2.48	-1.40
941.00	23.93	38.05	914.84	141.70	112.90	181.17	2.65	2.64	-0.49
1,036.00	26.51	38.01	1,000.78	173.58	137.83	221.65	2.72	2.72	-0.04
1,164.00	28.84	37.83	1,114.12	220.48	174.36	281.09	1.82	1.82	-0.14
Last SDI Surface MWD Survey									
1,274.00	28.89	38.93	1,210.46	262.10	207.33	334.19	0.48	0.05	1.00
First SDI Production MWD Survey									
1,369.00	30.17	37.82	1,293.12	298.81	236.39	381.01	1.47	1.35	-1.17
1,463.00	29.73	36.31	1,374.56	336.26	264.68	427.93	0.93	-0.47	-1.61
1,557.00	31.53	37.05	1,455.45	374.66	293.29	475.80	1.96	1.91	0.79
1,652.00	31.45	36.42	1,536.46	414.43	322.97	525.40	0.36	-0.08	-0.66
1,746.00	31.30	38.69	1,616.71	453.22	352.80	574.33	1.27	-0.16	2.41
1,841.00	30.63	38.15	1,698.17	491.51	383.17	623.21	0.76	-0.71	-0.57
1,935.00	31.74	39.07	1,778.59	529.54	413.55	671.88	1.28	1.18	0.98
2,030.00	31.32	38.18	1,859.57	568.35	444.56	721.55	0.66	-0.44	-0.94
2,125.00	30.69	38.52	1,940.99	606.73	474.92	770.49	0.69	-0.66	0.36
2,219.00	31.68	38.67	2,021.41	644.77	505.28	819.16	1.06	1.05	0.16
2,313.00	30.86	37.97	2,101.75	683.05	535.54	867.95	0.95	-0.87	-0.74
2,408.00	30.49	37.79	2,183.46	721.30	565.30	916.42	0.40	-0.39	-0.19
2,502.00	30.95	38.34	2,264.27	759.11	594.91	964.44	0.57	0.49	0.59
2,597.00	30.01	38.15	2,346.14	796.95	624.74	1,012.62	0.99	-0.99	-0.20
2,691.00	30.94	38.54	2,427.15	834.34	654.31	1,060.30	1.01	0.99	0.41
2,786.00	29.62	38.03	2,509.19	871.93	684.00	1,108.20	1.42	-1.39	-0.54
2,880.00	30.67	38.72	2,590.48	908.94	713.30	1,155.40	1.18	1.12	0.73
2,975.00	30.59	37.68	2,672.22	946.97	743.23	1,203.80	0.56	-0.08	-1.09
3,069.00	31.49	38.03	2,752.76	985.24	772.98	1,252.27	0.98	0.96	0.37
3,164.00	30.60	37.92	2,834.15	1,023.86	803.13	1,301.26	0.94	-0.94	-0.12
3,258.00	31.83	39.22	2,914.54	1,061.94	833.50	1,349.97	1.49	1.31	1.38
3,353.00	31.58	38.63	2,995.37	1,100.78	864.87	1,399.89	0.42	-0.26	-0.62
3,447.00	30.69	38.43	3,075.83	1,138.80	895.15	1,448.50	0.95	-0.95	-0.21
3,542.00	29.97	38.14	3,157.82	1,176.45	924.87	1,496.47	0.77	-0.76	-0.31
3,636.00	29.32	37.13	3,239.52	1,213.27	953.27	1,542.96	0.87	-0.69	-1.07
3,731.00	28.58	36.50	3,322.65	1,250.08	980.82	1,588.93	0.84	-0.78	-0.66
3,826.00	27.96	39.13	3,406.32	1,285.63	1,008.40	1,633.91	1.46	-0.65	2.77
3,920.00	27.33	38.32	3,489.59	1,319.65	1,035.68	1,677.52	0.78	-0.67	-0.86
4,014.00	26.38	37.90	3,573.45	1,353.06	1,061.89	1,719.98	1.03	-1.01	-0.45
4,109.00	25.47	37.44	3,658.89	1,385.93	1,087.28	1,761.51	0.98	-0.96	-0.48
4,203.00	23.66	38.16	3,744.38	1,416.81	1,111.22	1,800.59	1.95	-1.93	0.77
4,298.00	22.94	37.59	3,831.63	1,446.47	1,134.29	1,838.16	0.79	-0.76	-0.60
4,392.00	22.02	37.31	3,918.49	1,475.00	1,156.15	1,874.10	0.99	-0.98	-0.30
4,487.00	20.90	36.44	4,006.90	1,502.80	1,177.01	1,908.84	1.23	-1.18	-0.92

Company:	TEP Rocky Mountain LLC	Local Co-ordinate Reference:	Well SR 41-12 - Slot B7
Project:	Garfield County, CO NAD83	TVD Reference:	GL 7254' & RKB 24' @ 7278.00usft (H&P 318)
Site:	RU 32-12 Pad	MD Reference:	GL 7254' & RKB 24' @ 7278.00usft (H&P 318)
Well:	SR 41-12	North Reference:	True
Wellbore:	OH	Survey Calculation Method:	Minimum Curvature
Design:	OH	Database:	Grand Junction District



Survey										
Measured Depth (usft)	Inclination (°)	Azimuth (°)	Vertical Depth (usft)	+N/-S (usft)	+E/-W (usft)	Vertical Section (usft)	Dogleg Rate (°/100usft)	Build Rate (°/100usft)	Turn Rate (°/100usft)	
4,581.00	20.42	35.40	4,094.85	1,529.66	1,196.47	1,941.98	0.64	-0.51	-1.11	
4,676.00	19.33	34.89	4,184.19	1,556.06	1,215.06	1,974.22	1.16	-1.15	-0.54	
4,770.00	18.41	34.97	4,273.14	1,580.99	1,232.47	2,004.57	0.98	-0.98	0.09	
4,865.00	18.06	33.63	4,363.37	1,605.54	1,249.22	2,034.22	0.57	-0.37	-1.41	
4,959.00	16.20	37.09	4,453.20	1,628.14	1,265.20	2,061.86	2.26	-1.98	3.68	
5,054.00	15.26	36.72	4,544.64	1,648.73	1,280.67	2,087.60	1.00	-0.99	-0.39	
5,148.00	14.78	35.90	4,635.43	1,668.36	1,295.09	2,111.95	0.56	-0.51	-0.87	
5,242.00	13.10	42.38	4,726.66	1,685.94	1,309.31	2,134.56	2.44	-1.79	6.89	
5,337.00	11.84	40.78	4,819.42	1,701.27	1,322.93	2,155.03	1.38	-1.33	-1.68	
5,431.00	11.57	39.73	4,911.46	1,715.83	1,335.25	2,174.09	0.37	-0.29	-1.12	
5,525.00	10.17	44.58	5,003.78	1,728.99	1,347.10	2,191.77	1.78	-1.49	5.16	
5,620.00	9.13	43.94	5,097.43	1,740.39	1,358.22	2,207.60	1.10	-1.09	-0.67	
5,715.00	8.87	40.80	5,191.26	1,751.36	1,368.24	2,222.42	0.58	-0.27	-3.31	
5,809.00	7.59	51.71	5,284.30	1,760.69	1,377.85	2,235.70	2.14	-1.36	11.61	
5,904.00	6.74	51.83	5,378.56	1,768.03	1,387.15	2,247.23	0.89	-0.89	0.13	
5,998.00	5.64	56.39	5,472.01	1,773.99	1,395.34	2,256.99	1.28	-1.17	4.85	
6,090.37	5.10	50.98	5,563.97	1,779.09	1,402.31	2,265.31	0.80	-0.59	-5.86	
SR 41-12 MVRD										
6,092.00	5.09	50.87	5,565.60	1,779.18	1,402.42	2,265.45	0.80	-0.56	-6.48	
6,187.00	4.84	45.81	5,660.24	1,784.64	1,408.56	2,273.54	0.53	-0.26	-5.33	
6,281.00	3.92	46.49	5,753.96	1,789.61	1,413.74	2,280.65	0.98	-0.98	0.72	
6,375.00	2.13	52.15	5,847.83	1,792.90	1,417.45	2,285.53	1.93	-1.90	6.02	
6,469.00	1.64	48.66	5,941.78	1,794.86	1,419.83	2,288.55	0.54	-0.52	-3.71	
6,564.00	1.06	25.51	6,036.75	1,796.55	1,421.23	2,290.74	0.83	-0.61	-24.37	
6,658.00	1.14	20.85	6,130.73	1,798.21	1,421.94	2,292.48	0.13	0.09	-4.96	
6,753.00	0.92	17.67	6,225.72	1,799.82	1,422.51	2,294.09	0.24	-0.23	-3.35	
6,847.00	0.94	0.92	6,319.71	1,801.31	1,422.75	2,295.41	0.29	0.02	-17.82	
6,942.00	0.79	334.01	6,414.70	1,802.67	1,422.48	2,296.32	0.45	-0.16	-28.33	
7,036.00	1.47	320.00	6,508.68	1,804.18	1,421.42	2,296.84	0.78	0.72	-14.90	
7,131.00	1.23	6.17	6,603.65	1,806.13	1,420.74	2,297.95	1.14	-0.25	48.60	
7,225.00	1.41	20.41	6,697.63	1,808.21	1,421.26	2,299.90	0.40	0.19	15.15	
7,320.00	0.76	2.64	6,792.61	1,809.94	1,421.69	2,301.53	0.76	-0.68	-18.71	
7,414.00	1.09	348.82	6,886.60	1,811.44	1,421.55	2,302.61	0.42	0.35	-14.70	
7,509.00	0.82	355.24	6,981.59	1,813.00	1,421.32	2,303.70	0.31	-0.28	6.76	
7,603.00	0.43	7.10	7,075.58	1,814.02	1,421.30	2,304.49	0.43	-0.41	12.62	
7,698.00	0.64	40.74	7,170.58	1,814.78	1,421.69	2,305.32	0.39	0.22	35.41	
7,792.00	0.48	33.26	7,264.57	1,815.51	1,422.25	2,306.24	0.19	-0.17	-7.96	
7,886.00	0.49	43.46	7,358.57	1,816.13	1,422.74	2,307.03	0.09	0.01	10.85	
7,981.00	0.64	353.23	7,453.56	1,816.95	1,422.96	2,307.81	0.52	0.16	-52.87	
8,075.00	0.21	116.04	7,547.56	1,817.39	1,423.05	2,308.22	0.82	-0.46	130.65	
8,170.00	0.51	152.70	7,642.56	1,816.94	1,423.40	2,308.08	0.38	0.32	38.59	
8,264.00	0.64	206.32	7,736.56	1,816.10	1,423.36	2,307.40	0.57	0.14	57.04	
8,359.00	0.97	223.26	7,831.55	1,815.04	1,422.58	2,306.08	0.42	0.35	17.83	

Company:	TEP Rocky Mountain LLC	Local Co-ordinate Reference:	Well SR 41-12 - Slot B7
Project:	Garfield County, CO NAD83	TVD Reference:	GL 7254' & RKB 24' @ 7278.00usft (H&P 318)
Site:	RU 32-12 Pad	MD Reference:	GL 7254' & RKB 24' @ 7278.00usft (H&P 318)
Well:	SR 41-12	North Reference:	True
Wellbore:	OH	Survey Calculation Method:	Minimum Curvature
Design:	OH	Database:	Grand Junction District

Survey									
Measured Depth (usft)	Inclination (°)	Azimuth (°)	Vertical Depth (usft)	+N/-S (usft)	+E/-W (usft)	Vertical Section (usft)	Dogleg Rate (°/100usft)	Build Rate (°/100usft)	Turn Rate (°/100usft)
8,453.00	1.14	230.47	7,925.53	1,813.86	1,421.31	2,304.37	0.23	0.18	7.67
8,547.00	0.79	193.83	8,019.52	1,812.64	1,420.43	2,302.87	0.74	-0.37	-38.98
8,642.00	1.06	179.58	8,114.51	1,811.12	1,420.28	2,301.58	0.37	0.28	-15.00
8,736.00	1.58	180.90	8,208.48	1,808.96	1,420.27	2,299.88	0.55	0.55	1.40
8,831.00	1.23	190.66	8,303.45	1,806.65	1,420.06	2,297.93	0.45	-0.37	10.27
8,925.00	1.26	167.49	8,397.43	1,804.65	1,420.10	2,296.39	0.53	0.03	-24.65
9,020.00	1.76	177.65	8,492.40	1,802.17	1,420.38	2,294.62	0.60	0.53	10.69
9,114.00	2.37	170.44	8,586.34	1,798.81	1,420.77	2,292.23	0.70	0.65	-7.67
9,208.00	2.48	165.84	8,680.25	1,794.92	1,421.59	2,289.68	0.24	0.12	-4.89
9,303.00	1.62	174.65	8,775.19	1,791.59	1,422.22	2,287.46	0.96	-0.91	9.27
9,397.00	2.02	170.35	8,869.14	1,788.64	1,422.62	2,285.39	0.45	0.43	-4.57
9,492.00	2.81	136.52	8,964.06	1,785.30	1,424.50	2,283.94	1.68	0.83	-35.61
9,586.00	2.55	143.90	9,057.96	1,781.93	1,427.32	2,283.05	0.46	-0.28	7.85
9,681.00	0.98	172.98	9,152.91	1,779.42	1,428.66	2,281.91	1.85	-1.65	30.61
9,821.00	0.62	191.97	9,292.90	1,777.49	1,428.65	2,280.39	0.32	-0.26	13.56
Last SDI Production MWD Survey									
9,883.00	0.62	191.97	9,354.90	1,776.83	1,428.51	2,279.79	0.00	0.00	0.00
Projection to TD - SR 41-12 PBHL									

Design Annotations				
Measured Depth (usft)	Vertical Depth (usft)	Local Coordinates		Comment
		+N/-S (usft)	+E/-W (usft)	
125.00	125.00	0.38	-0.04	First SDI Gyro MWD Survey
678.00	668.61	70.12	55.17	Last SDI Gyro MWD Survey
752.00	739.01	87.71	69.67	First SDI Surface MWD Survey
1,164.00	1,114.12	220.48	174.36	Last SDI Surface MWD Survey
1,274.00	1,210.46	262.10	207.33	First SDI Production MWD Survey
9,821.00	9,292.90	1,777.49	1,428.65	Last SDI Production MWD Survey
9,883.00	9,354.90	1,776.83	1,428.51	Projection to TD

Checked By: _____ Approved By: _____ Date: _____

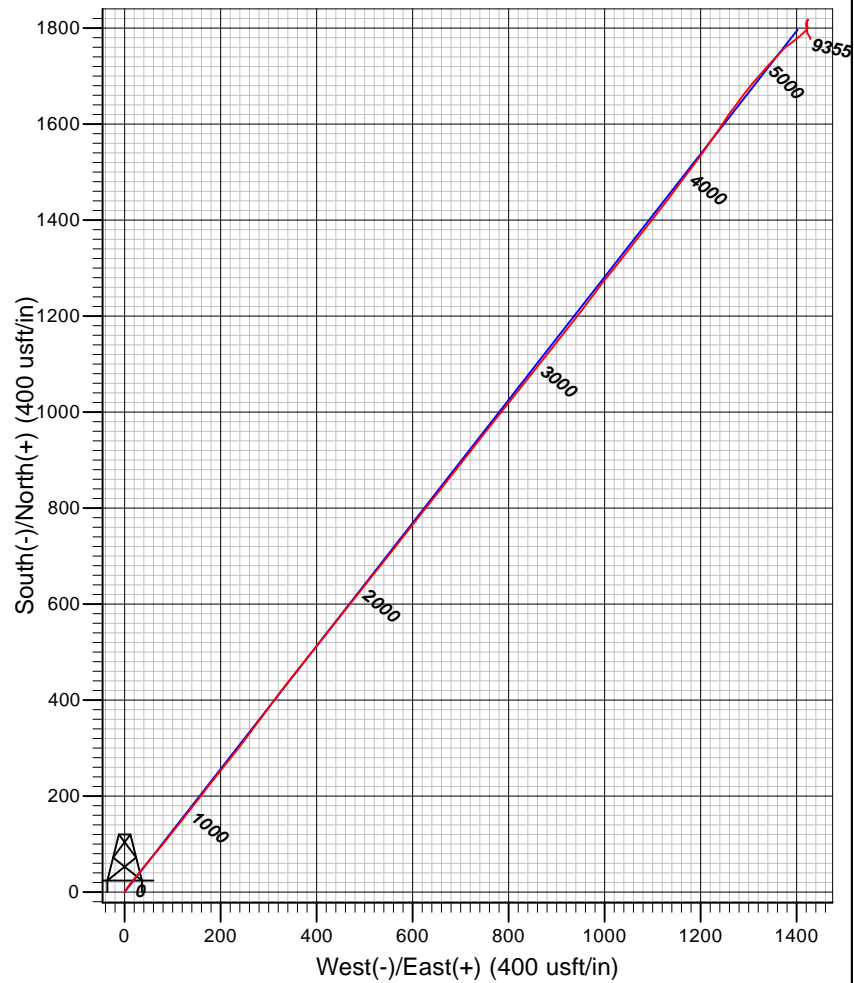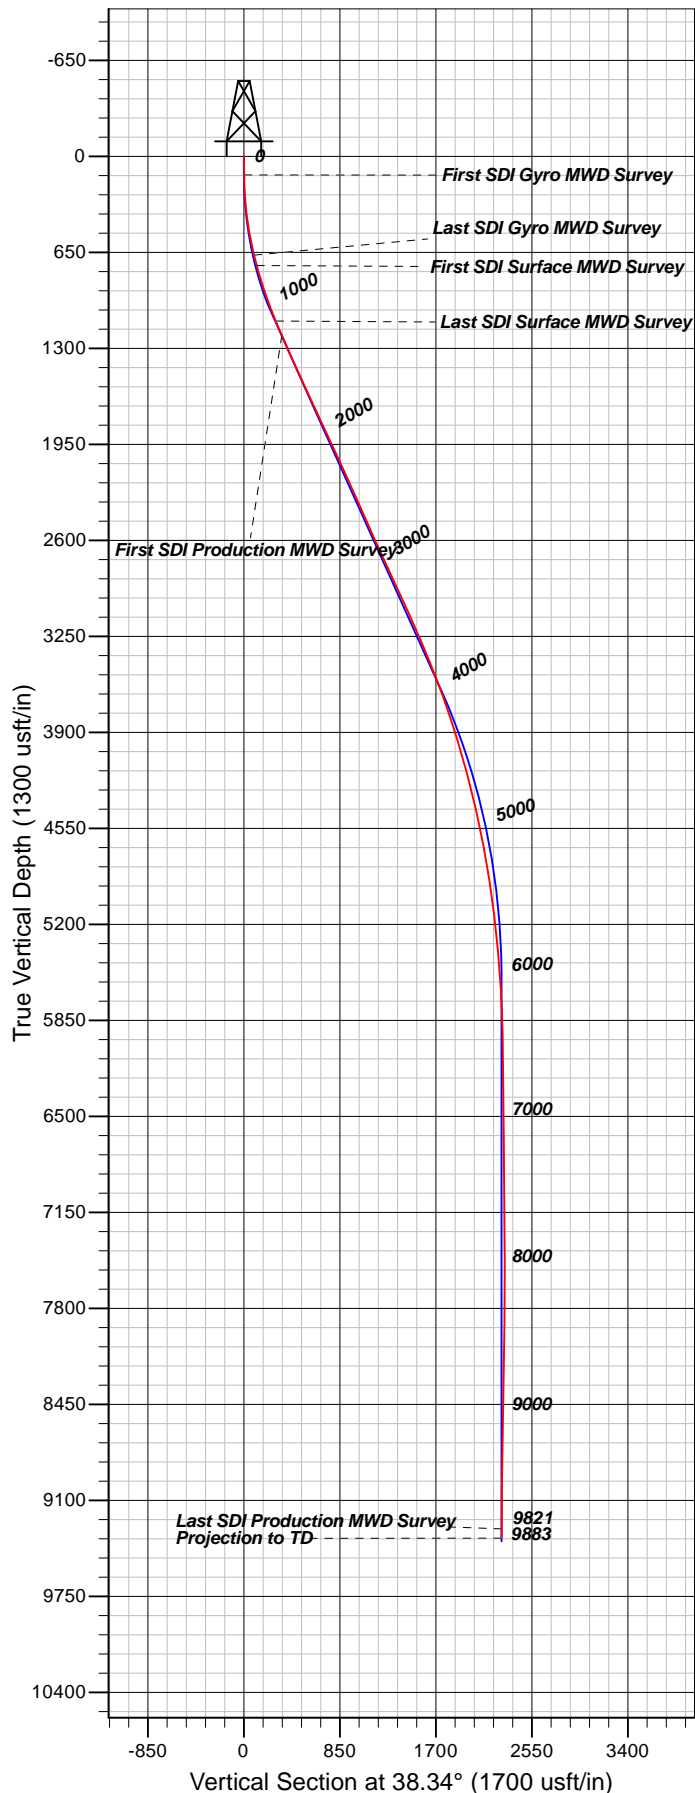

Well Details: SR 41-12

TVD Reference: GL 7254' & RKB 24' @ 7278.00usft (H&P 318)		Datum Level: 7254.00		Slot	
+N/-S	+E/-W	Northing	Easting	Latitude	Longitude
0.00	0.00	1599211.80	2341070.00	39.4553682	-107.8338809

Slot B7

REFERENCE INFORMATION

Co-ordinate (N/E) Reference: Well SR 41-12 - Slot B7, True North
 Vertical (TVD) Reference: GL 7254' & RKB 24' @ 7278.00usft (H&P 318)
 Section (VS) Reference: Slot - B7(0.00N, 0.00E)
 Measured Depth Reference: GL 7254' & RKB 24' @ 7278.00usft (H&P 318)
 Calculation Method: Minimum Curvature

PROJECT DETAILS: Garfield County, CO NAD83

Geodetic System: US State Plane 1983
 Datum: North American Datum 1983
 Ellipsoid: GRS 1980
 Zone: Colorado Central Zone

System Datum: Mean Sea Level

Plan: OH

13:46, August 14 2017
 Created By: Mel Mireles Jr.