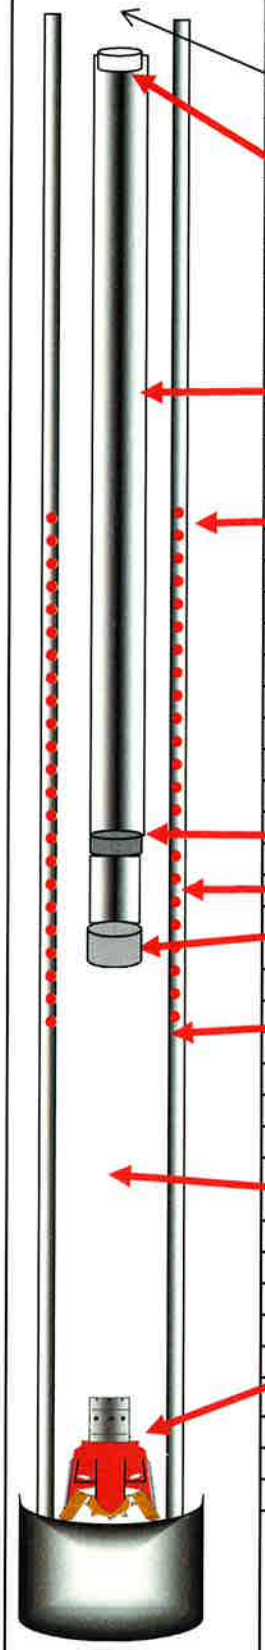

COMPANY	Laramie Energy LLC	05-077-10370-0000	CASING	LINER	TUBING
WELL NAME	Bruton 30-02E	SIZE:	4.5		2.375
FIELD	Bruton 30-01	WEIGHT:	11#		4.7#
COUNTY	MESA	GRADE:			L80
STATE	COLORADO	THREAD:			8rd EUE
DATE	Wednesday, November 01, 2017	DEPTH:	8214	EOT w/KB	7,074.53
					LENGTH
ITEM	DESCRIPTION		OD	ID	FEET
	K.B.				24.00
	Tubing Hanger Cameron 7 1/16" 5 K Hanger		7.063	1.901	0.86
	215 JTS 2 3/8" 4.7# EUE L-80		2.375	1.901	7,015.56
	TOP PERF 6040'				
	Zones: Cameo, Williams Fork				
	Baker F-Nipple 1.810"		3.125	1.810	0.84
	1 JT 2 3/8" 4.7# EUE L-80		2.375	1.901	32.64
	1/2 POBS		3.250	2.000	0.63
	BOTTOM PERF 7448'				
	1/2 POBS & 3 3/4" Mill @				
P.B.T.D			**EOT w/ K.B.**		**7,074.53**

PREPARED FOR: