



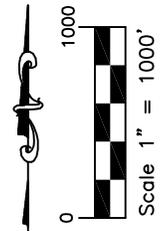

WELL LOCATION CERTIFICATE

THIS MAP DOES NOT REPRESENT A BOUNDARY SURVEY

Washburn Land Surveying
www.WashburnSurveying.com
970-232-9645

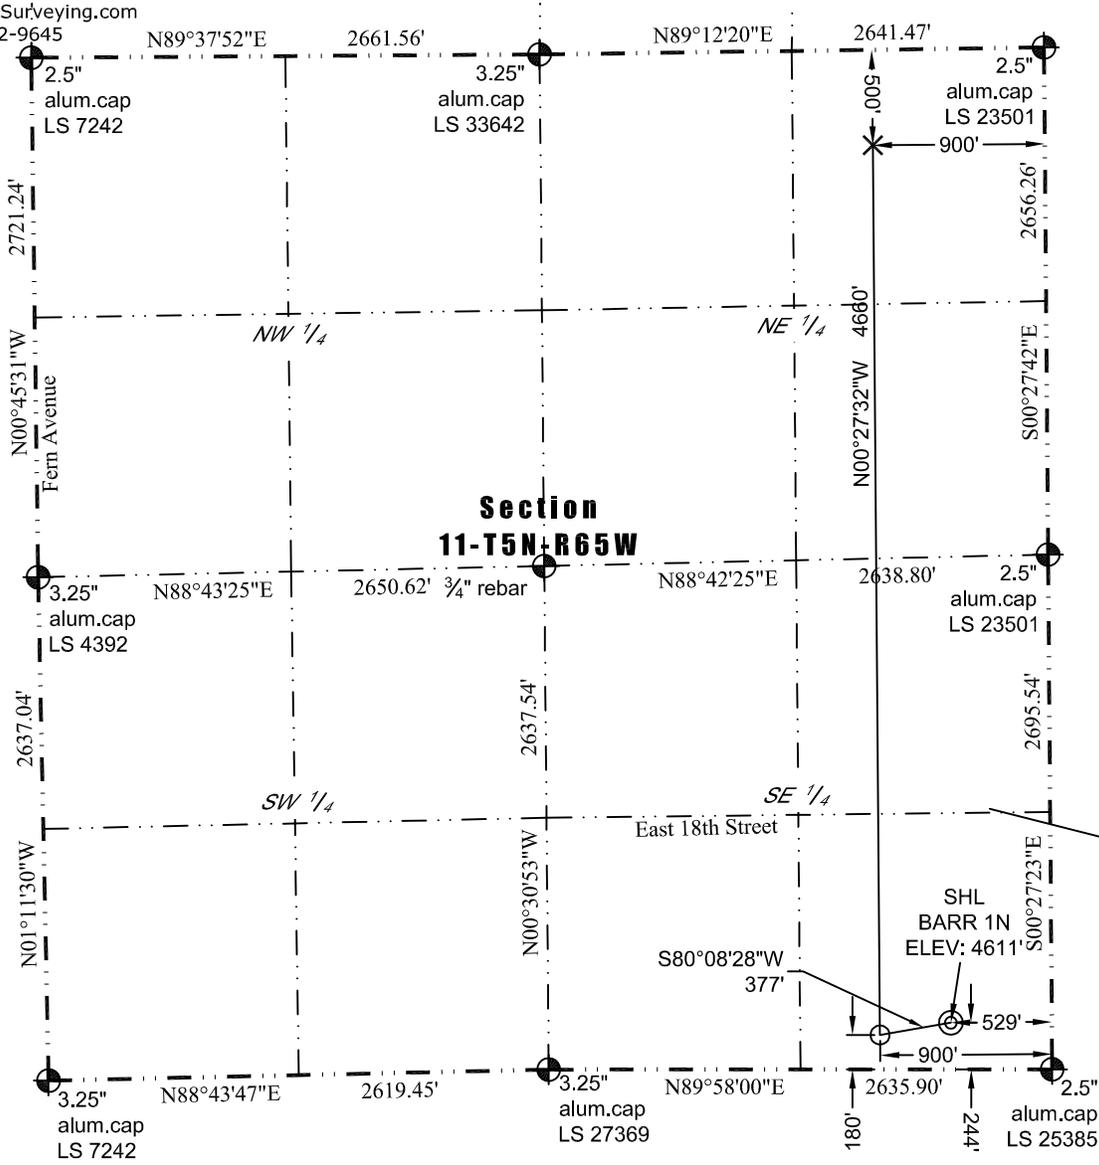

In accordance with a request from Barney Hammond of PDC Energy, Inc., Washburn Land Surveying, LLC has determined the location of the **BARR 1N** well site to be SHL: 244' FSL and 529' FEL, (BHL: 500' FNL and 900' FEL), as measured at ninety (90) degrees from the section lines of Section 11, Township 5 North, Range 65 West of the 6th Principal Meridian, Weld County Colorado.

<u>Proposed Surface Hole Data:</u> Latitude: N 40.407311° Longitude: W 104.622989° PDOP: 1.8	<u>Proposed Entry Point Data:</u> Latitude: N 40.407144° Longitude: W 104.624324°	<u>Proposed Bottom Hole Data:</u> Latitude: N 40.419935° Longitude: W 104.624292°
---	---	---

LEGEND

- ⊕ - Found Survey Monument
- - Calculated Location
- ⊙ - Surface Hole Location (SHL)
- - Entry Point Location (EPL)
- ⊗ - Bottom Hole Location (BHL)

Nearest Cultural Items:

Building: 721' SW	Property Line: 529' E
Building Unit: 953' SE	Railroad: +5280'
Above Ground Utility: 667' SE	High Occupancy Building Unit: +5280'
Public Road: 1127' N	Designated Outside Activity Area: +5280'

Notes:

- 1) Bearings and distances based on NAD 83 Colorado North State Plane Coordinate, using RTK GPS observations taken 9/8/16 by operator Jason Dahlman.
- 2) Conversion factor to ground (1.0002577355).
- 3) Elevations based on NAVD 88 GPS heights and Geoid 2009 corrections.
- 4) See Location Drawing for visible improvements within 500 feet of Pad Site.
- 5) The surface use is an uncultivated field.

NOTICE: According to Colorado law you must commence any legal action based upon any defect in this W.L.C. within three years after you first discover such defect. In no event may any action based upon any defect in this W.L.C. be commenced more than ten years from this said date of the certification shown hereon.

I hereby certify that this Well Location Certificate was prepared by me or under my direct supervision on 10/23/2017 for and on behalf of PDC Energy, Inc. that it is not a Land Survey Plat or an Improvement Survey Plat and that it is not to be relied upon for establishment of fences, buildings, or other future improvement lines.

John Robert McGehee LS#38219
Well: BARR 1N W.L.C.

