


Before Plugging:

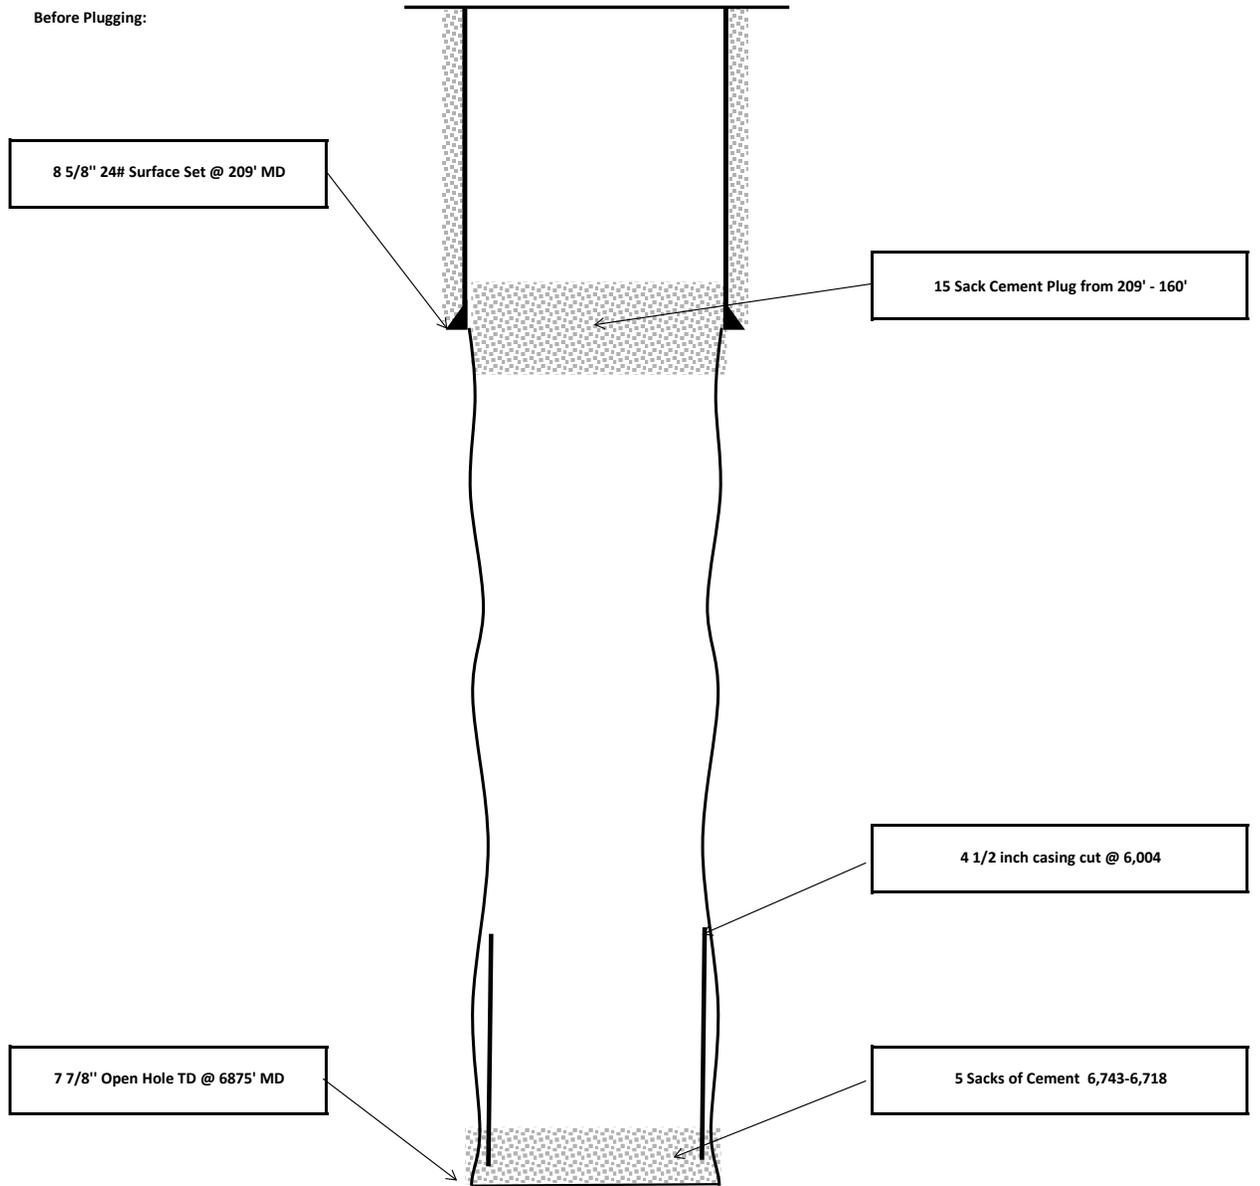

8 5/8" 24# Surface Set @ 209' MD

15 Sack Cement Plug from 209' - 160'

4 1/2 inch casing cut @ 6,004

7 7/8" Open Hole TD @ 6875' MD

5 Sacks of Cement 6,743-6,718