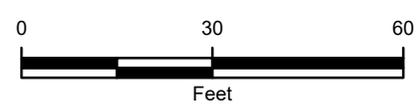


IMAGE COURTESY OF GOOGLE EARTH 2015

**LEGEND**

- SOIL SAMPLE
- ⊕ GROUNDWATER SAMPLE
- - - IRRIGATION DITCH
- x — x FORMER FENCE
- ⬡ EXCAVATION EXTENT
- ▭ BERM
- ▭ FORMER BERM
- AST: ABOVEGROUND STORAGE TANK



**FIGURE 1**  
**EXCAVATION SITE MAP**  
**AUGUST LAMBRECHT GU #2**  
**SWNW SEC 12-T1N-R67W**  
**WELD COUNTY, COLORADO**  
**KERR-MCGEE OIL & GAS ONSHORE LP**

