



Red Mesa Holdings, LLC - Operator # 10254

API No. 067-07085
 Talbot-Wideman # 13-1
 NESW 13 33N 12W
 La Plata County, CO

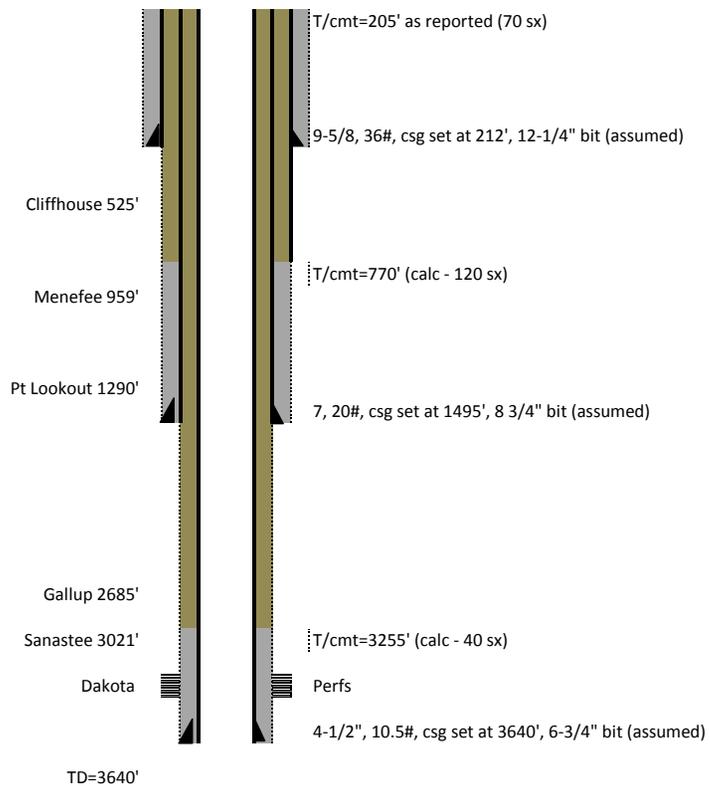

AS REPORTED 1988

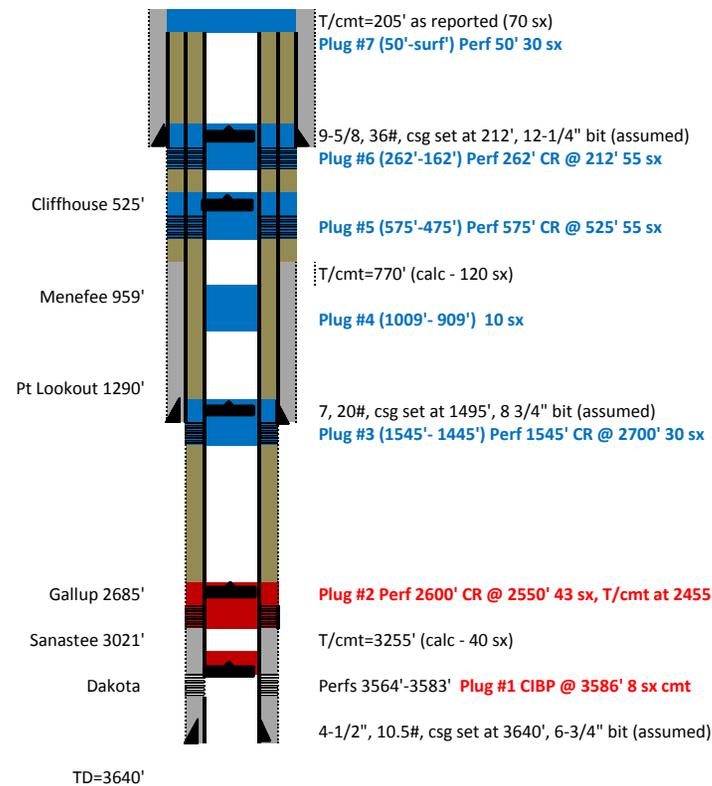

PLUGGING DESIGN

11/13/17 Plugs 1 & 2 set