




H-C #1-7

Shakespeare Oil Company, Inc.

12 1/4" hole

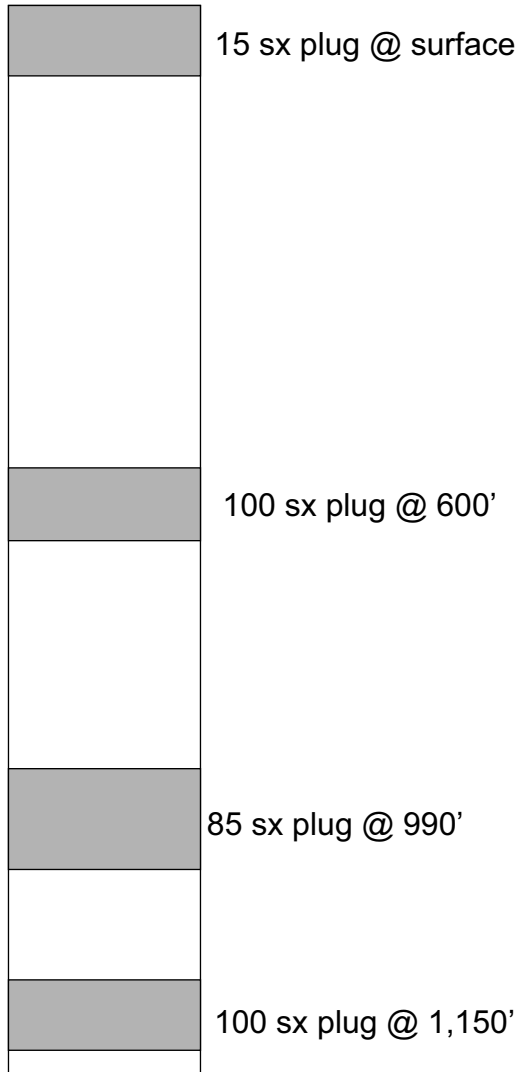

Date: 12/11/17
Well Name: H-C #1-7
Location: 2035' FSL, 1591' FWL
7-33S-41W
County: Baca
State: Colorado
API: 05-009-06680-00
Surface Casing: None
Cement: 305 sacks
Total Depth: 1162'
P&A Date: 12/10/17