

FRED BRUNNER JR 2
05-123-05318

Line offset

BLVD @ 62'

16" conductor
set @ 28' w/ 100sx

10 3/4" 40.5# SC
set @ 518' w/ 400sx

Set 15sx @ 500'


SX Road within 1 mile

SX Top: 4265'

N10 Top: 6825'

TCC: unknown
(estimated 8043')

7" csq set @ 9031'
w/ 350sx

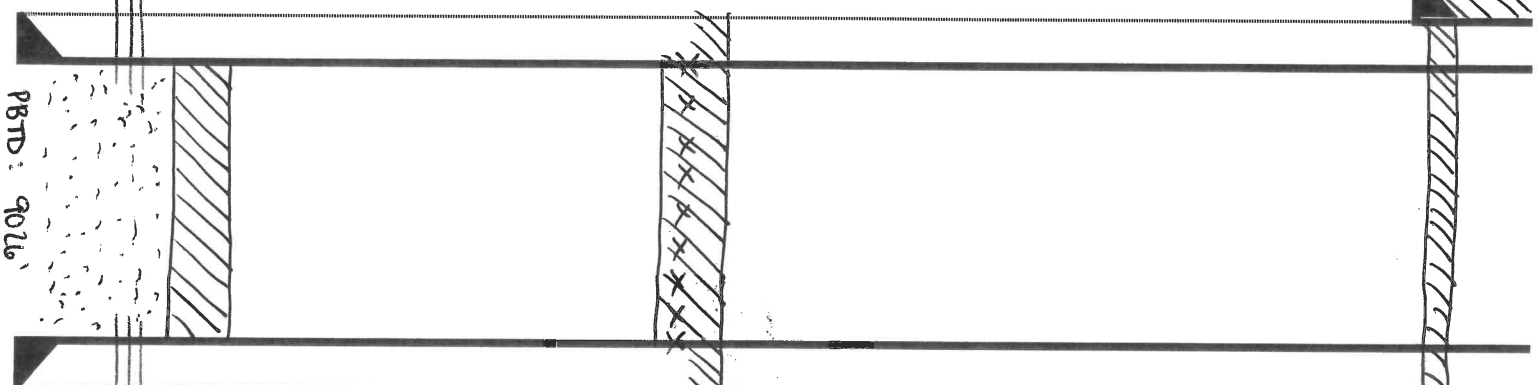

8949'
8976'

PRPD: 9026'

10 sx from 8940' - 8960'

Set sand over puffs to 8940'

Est TCC: 10 3/4" csq diff: 9,894"

283.619/21 h = 350sx (14 7/8x)

h = 1234' x .8 = 988.72

9031' - 988' = 8043'

Need to remediate

(No coverage)