




WELLBORE DIAGRAM

CURRENT WBD

1320' FSL & 990' FWL

1 Mile Offset
PR Sussex
Deepest WW: 1145'

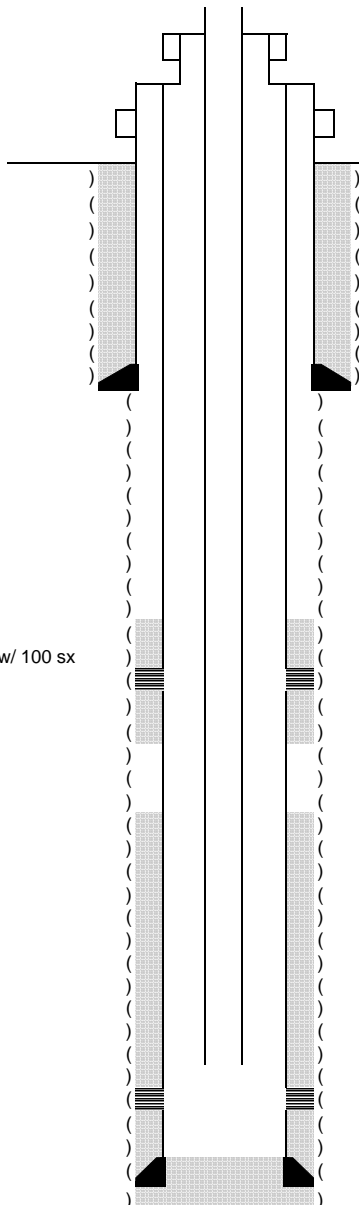

DV tool set @ 5185' cmt'd w/ 100 sx
TOC: 4838' (Calc)

KB ' 5239'

GL ' 5228'

Spud Date: 4/30/1971
Date TD Reached 5/18/1971
Completion Date:

Surface Casing
(12-1/4" Hole Size) 8-5/8" 24# csg set @ 253'
w/ 170 sx cmt

Production casing
(7-7/8" Hole Size) 4-1/2" 10.5 & 11.6# csg set @ 8620'
w/ 235 sx

Tubing
2-3/8" tbg set @ 8543' (1994)

TOC = 7804' (calc)

Formation Tops
Base FoxHills 1099'
Sussex 5103'
Niobrara 7650'
Timpas 8068'
Codell 8090'
J Sand 8504'

Perforations
Sussex (1971)
5103-5113'

J-Sand (1971)
8543-8551'

TVD =
MD = 8620'

PBTVD =
PBMD =

Operator: Great Western Operating Co. LLC
Well Name: Layton Green 1
Lease Number:
Location: SWSW S18-T1S-R67W
Field: Wattenberg - #90750
County, State: Adams, CO
API Number: 05-001-06281
Diagram Date: 12/5/2017
Lat/Long: 39.960982, -104.9368