



OIL AND GAS CONSERVATION COMMISSION OF THE STATE OF COLORADO



OIL & GAS
CONSERVATION COMMISSION

NOTICE OF INTENTION TO DRILL

INSTRUCTIONS:

A notice of intention to drill a well shall be filed in duplicate on all Federal and Patented lands, and in triplicate on all State lands. Do not begin operations until approved copy has been received. It is mandatory that the proposed location comply with all rules and regulations of the Commission. Locate well on section grid in proper location, and indicate extent of lease. Unless operations are commenced within 180 days after the date of approval hereof, this approval to drill will become null and void.

Name of Operator Skelly Oil Company Phone No. LA 2-0289
Address P. O. Drawer 310 City Sterling State Colorado


How is liability secured: Well Bond (Attached) ☐; Blanket Bond ☒; Waiver ☐
(Check one)

Lease Name L. E. Rieke

Well No. 3

Field Name Dale - North Wildcat ☐

County Logan

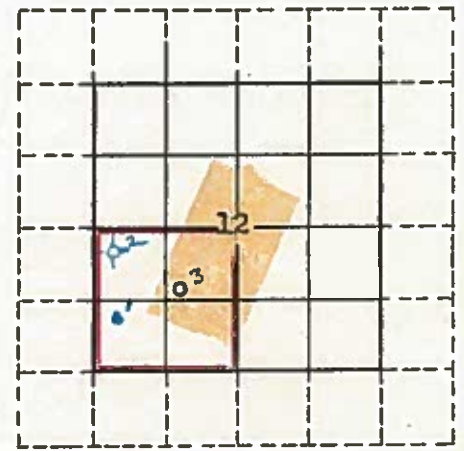

Location C SW/4 NE/4 SW/4 Section 12 Township 8N Range 53W Meridian 6th PM
(quarter quarter)
1650 feet from South Section line and 1650 feet from West Section Line
N or S E or W

The well is located on: Patented land ☒ State land ☐ Federal land ☐

The well is located within a spaced area: Yes ☒ No ☐ Current 69

Distance from proposed location to nearest property or lease line 1650 feet.
Distance from proposed location to nearest drilling unit line 330 feet. OK

Objectives: 3rd Dak. "J" Sd. Depth 5250' ; Formation Estimate Depth Estimate

Proposed length of surface casing 240 feet.

REMARKS:

We will run 8-5/8" OD surface casing and will cement same to top. If commercial production is encountered, we will set 5 1/2" OD casing and cement same above production zone.

Agent	<u>OK</u>
Bond	<u>Warrant</u>
Spot	<u>64-1</u>
600 ft.	<u>330 ft.</u>
1200 ft.	<u>1320 ft.</u>
Wells	
Oil	
Gas	
Status	

AJJ	
DVR	
WRS	<input checked="" type="checkbox"/>
HH/A	
JAM	
FJP	
JJD	
FILE	

I/We hereby swear (or affirm) that the statements herein made are a full and correct report.

APPROVED:

Date NOV 10 1958

Affirmed
Director

Company Skelly Oil Company Date Nov. 7, 1958

Address P. O. Drawer 310 Phone No. LA 2-0289
Sterling, Colorado

By C. F. Bass Title Dist. Supt.
Signature