




CERTIFICATE OF SURVEY
for
Clark Oil and Refining Co.
Weld County, Colorado

RECEIVED
FEB 15 1965

OIL & GAS
CONSERVATION COMMISSION

T9N R56W 6PM

GROUND ELEV
SESW Sec. 27 4457.4

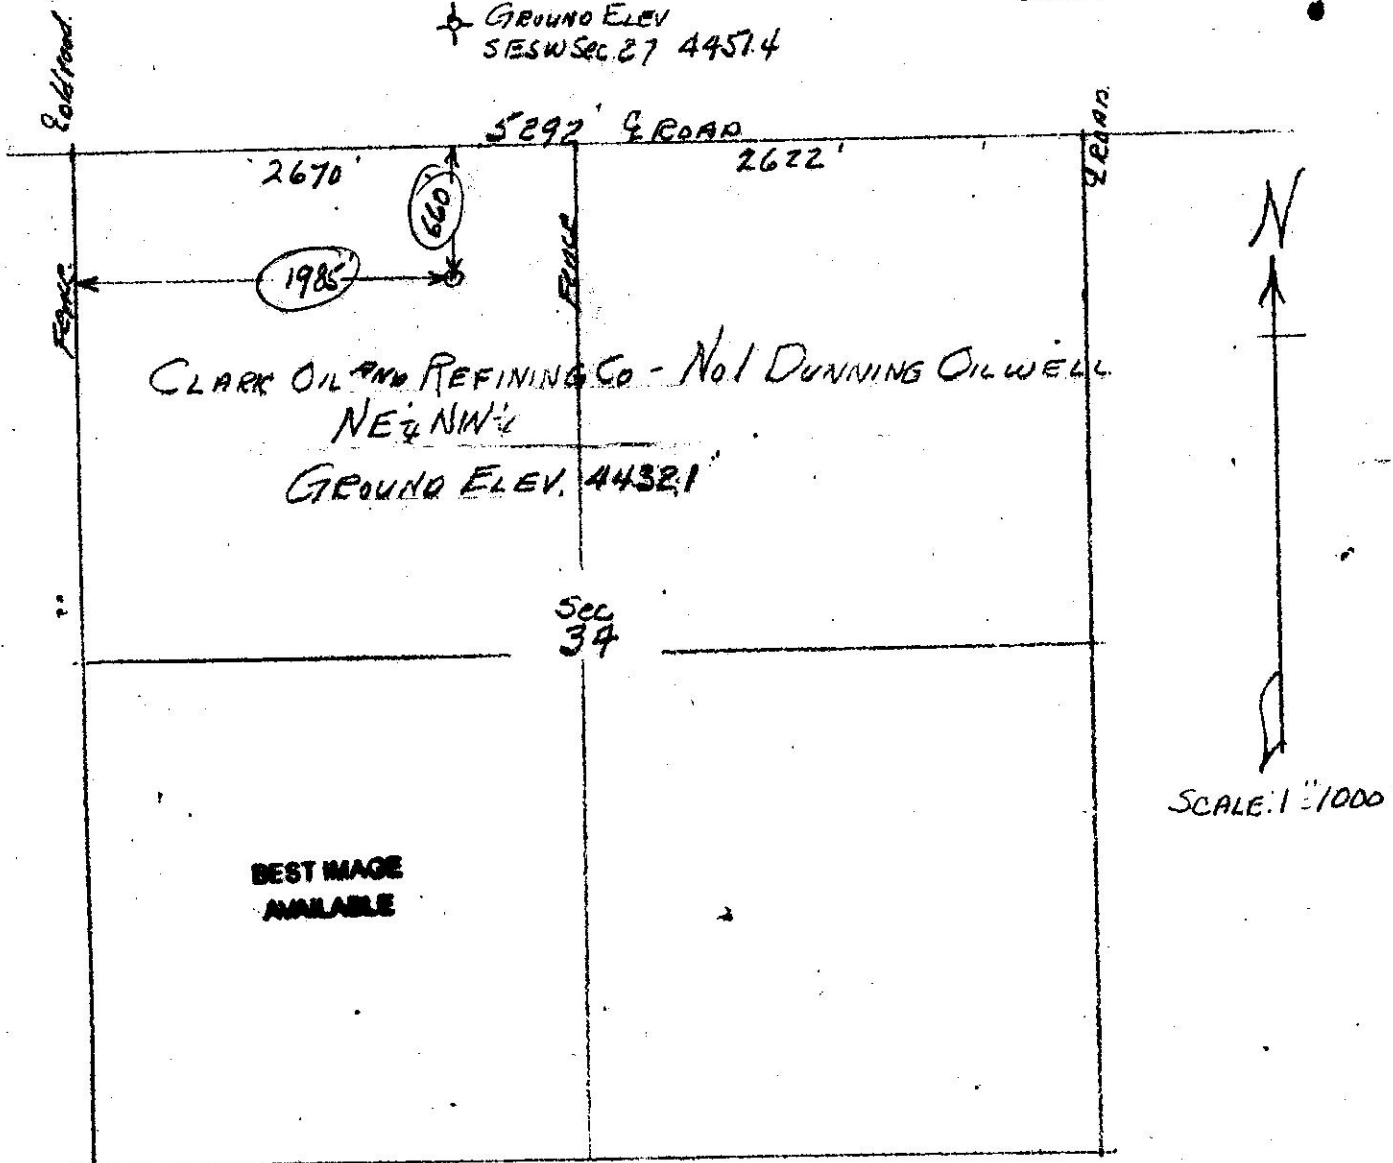

I hereby certify that the above plat is an accurate representation of a correct survey showing the location of Clark Oil and Refining Co.-No. 1 Dunning Oilwell in NE 1/4 NW 1/4 Sec. 34 T9N R56W 6PM. The elevation of the ground at the stake is 4432.1 feet above sea level from U.S.C.&G. Bench Mark.

Fort Morgan, Colorado
Feb. 7, 1965

Leuel J. Osborne
Registered Professional Engineer
State of Colorado

65-34

