




00239041

OFFICE OF STATE OIL INSPECTOR  
Oil and Gas Conservation  
Department

142-c

LOG OF OIL AND GAS WELL

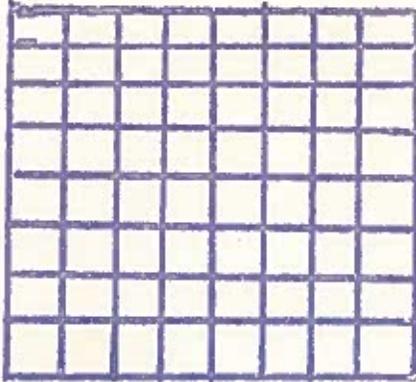

Locate  
Well  
Correctly

YENTER A-2.

Company British-American Oil Producing Address P.O. Box 620, Casper, Wyoming  
State or Patented Patented Field Yenter Block State Colorado  
Well No. 2 Sec. 3 T. 8 N R. 54 W Meridian \_\_\_\_\_ County Logan  
Location 330 Ft. <sup>(N)</sup> of S Line and 990 Ft. <sup>(E)</sup> of W line of G Elevation 4373  
Lot No. 6 (Derrick floor relative to sea level)

The information given herewith is a complete and correct record of the well and all work done thereon so far as can be determined from all available records.

Date September 26, 1951 Signed C. Wm. Evelyn, Jr. Title Sup't, Northwestern District

The summary on this page is for the condition of the well as above date.

Commenced drilling 1-14-, 1951 Finished Drilling 2-3 1951

OIL SANDS OR ZONES

No. 1, from 5099 to 5121 "D" No. 4, from \_\_\_\_\_ to \_\_\_\_\_  
No. 2, from 5211 to TD "J" No. 5, from \_\_\_\_\_ to \_\_\_\_\_  
No. 3, from \_\_\_\_\_ to \_\_\_\_\_ No. 6, from \_\_\_\_\_ to \_\_\_\_\_

IMPORTANT WATER SANDS

No. 1, from \_\_\_\_\_ to \_\_\_\_\_ No. 3, from \_\_\_\_\_ to \_\_\_\_\_  
No. 2, from \_\_\_\_\_ to \_\_\_\_\_ No. 4, from \_\_\_\_\_ to \_\_\_\_\_

CASING RECORD

Size	Weight per ft.	Threads per inch	Make	Amount	Kind of Shoe	Cut & Pulled from	Perforated From to	Purpose
9 5/8"	36#	8	J-55 S3	208'				
5 1/2"	15.5#	8	J-55 S3	5230'	Baker		5234'   5235'	

MUDDING AND CEMENTING RECORD

Size	Where Set	No. Sacks of Cement	Methods used	Mud Gravity	Amount of Mud Used
9 5/8"	207'	125 Sx	HOWCO		
5 1/2"	5230'	200 Sx	HOWCO		

PLUGS AND ADAPTERS

Heaving plug-Material \_\_\_\_\_ Length \_\_\_\_\_ Depth Set \_\_\_\_\_  
Adapters-Material \_\_\_\_\_ Size \_\_\_\_\_

SHOOTING RECORD

Size	Shell Used	Explosive Used	Quantity	Date	Depth Shot	Depth Cleaned Out

TOOLS USED

Rotary Tools used from 0 ft. to 5230 ft. and from \_\_\_\_\_ ft. to \_\_\_\_\_ ft.  
Cable tools were used from 5230 ft. to 5253 ft. and from \_\_\_\_\_ ft. to \_\_\_\_\_ ft.

DATES

September 26 1951 Put to producing 8-7- 1951  
The production for the first 24 hours was 127 barrels of fluid of which  
.13385 % was oil, .86615 % water, \_\_\_\_\_ % sediment. Gravity Be, 38 Est.  
If gas well, cu. ft. per 24 hours \_\_\_\_\_ Gallons gasoline per 1,000 cu. ft.  
of gas \_\_\_\_\_ Rock Pressure, lbs. per sq. in \_\_\_\_\_

EMPLOYEES

E. L. McCarter Driller W. O. Patton Driller  
G. H. Rizar Driller \_\_\_\_\_ Driller

FORMATION RECORD

From	To	Total Feet	Formation
0	3105	3105	Surface & Shale
3105	3360	255	Shale & Bentonite
3360	4976	1610	Shale
4970	5121	151	Sand & Sandy Shale
5121	5232	111	Shale & Sand.