




CERTIFICATE OF SURVEY  
for  
Willard Franks  
Weld County, Colorado

RECEIVED

MAR 29 1971

COLO. OIL & GAS CONS. COMM.

T7N R62W 6PM

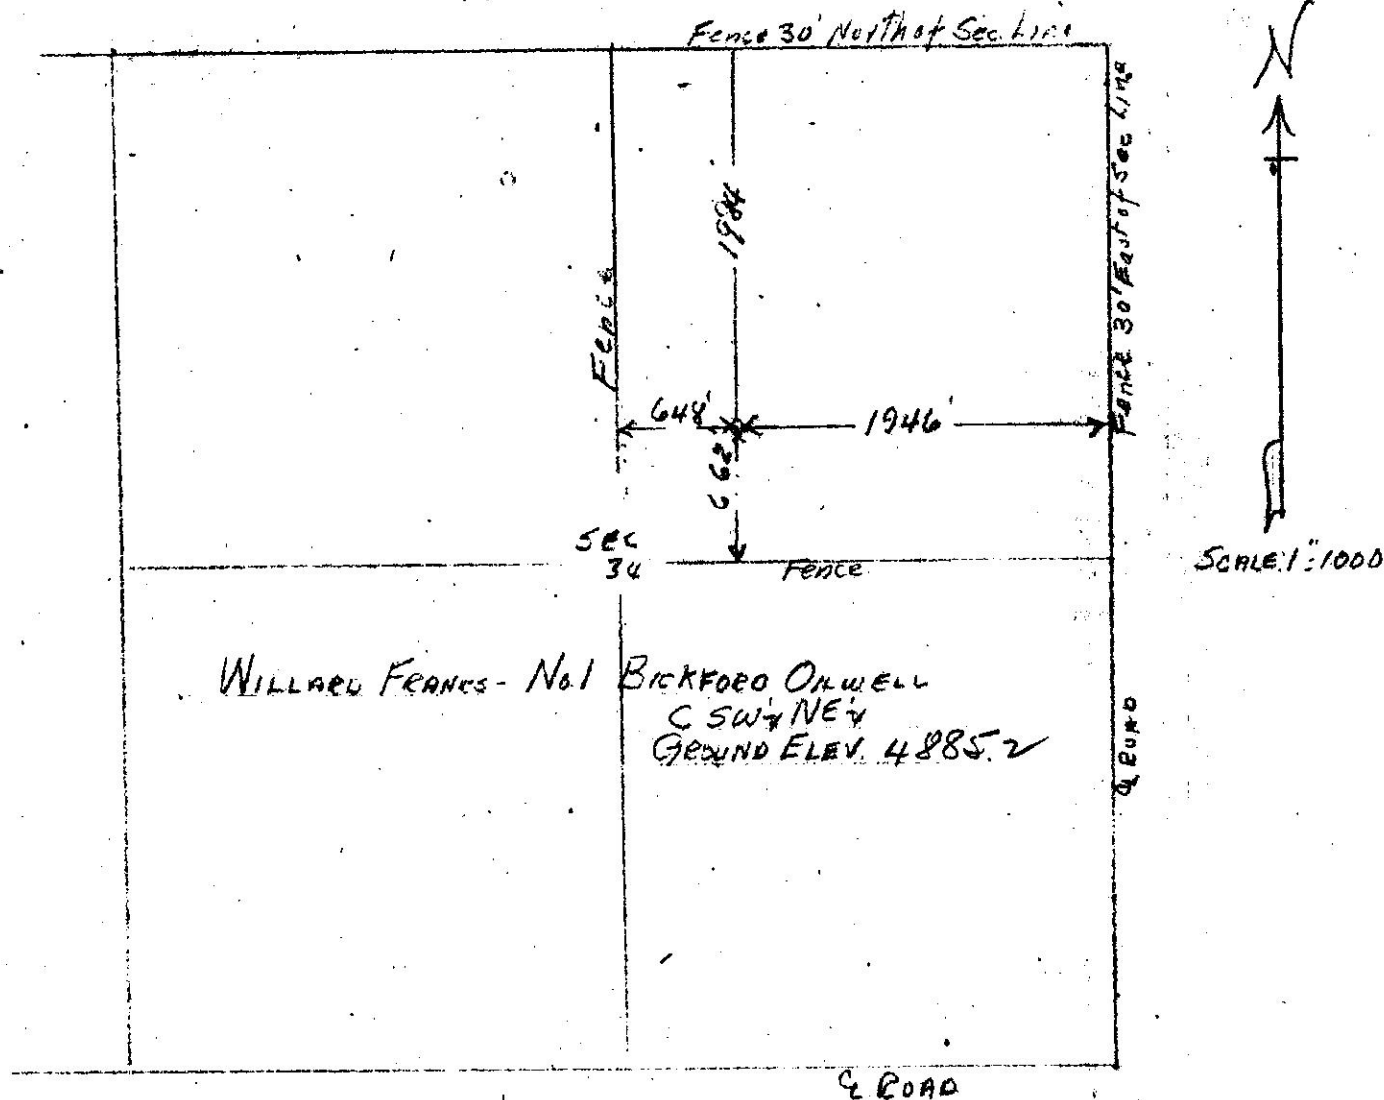

I hereby certify that the above plat is an accurate representation of a correct survey showing the location of Willard Franks- Bickford No.1 Oilwell in C SW 1/4 NE 1/4 Sec. 34 T7N R62W 6PM. The elevation of the ground at the stake is 4885.2 feet above sea level from U.S.C.S. Bench Mark.

Fort Morgan, Colorado  
Dec. 25, 1970

*Keith J. Osborne*  
Registered Professional Engineer  
State of Colorado