


CURRENT CONFIGURATION

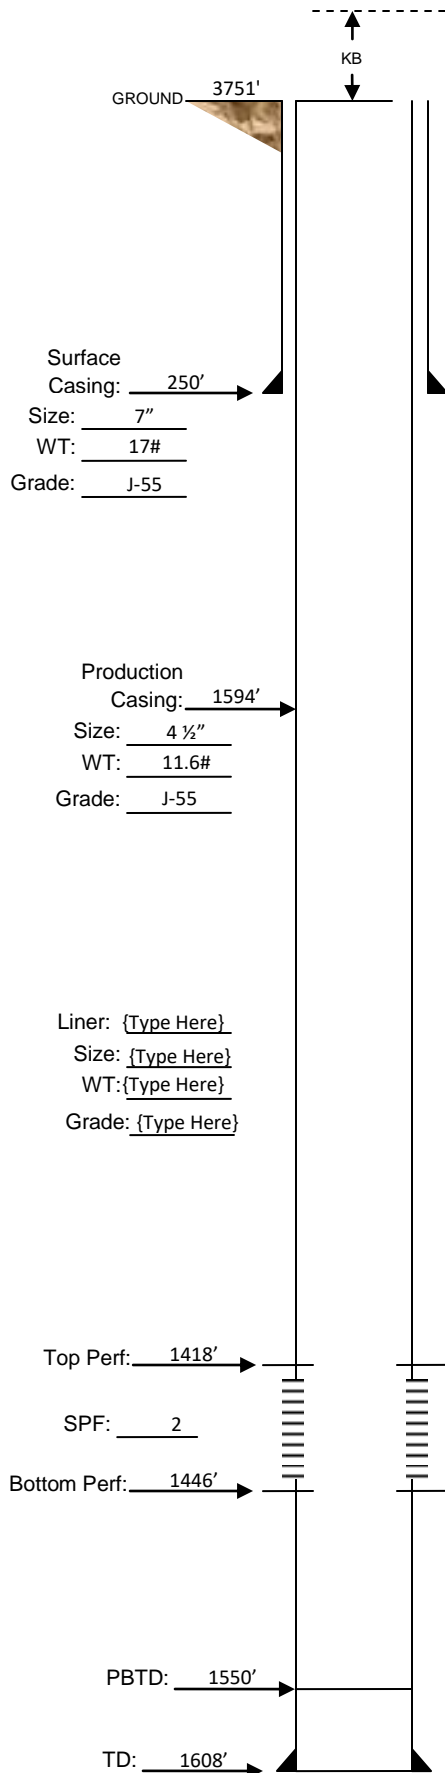

Well: Weyerman 6B-18

API: 05-125-09027-00

Location: SENW Sec. 18-T5S-R43W

County, State: Yuma, CO

Date: 11-30-2017

Co. Supervisor: Roelfs

Lat/Longs: 39.623557 -102.2266