


FINAL P&A WELLBORE DIAGRAM

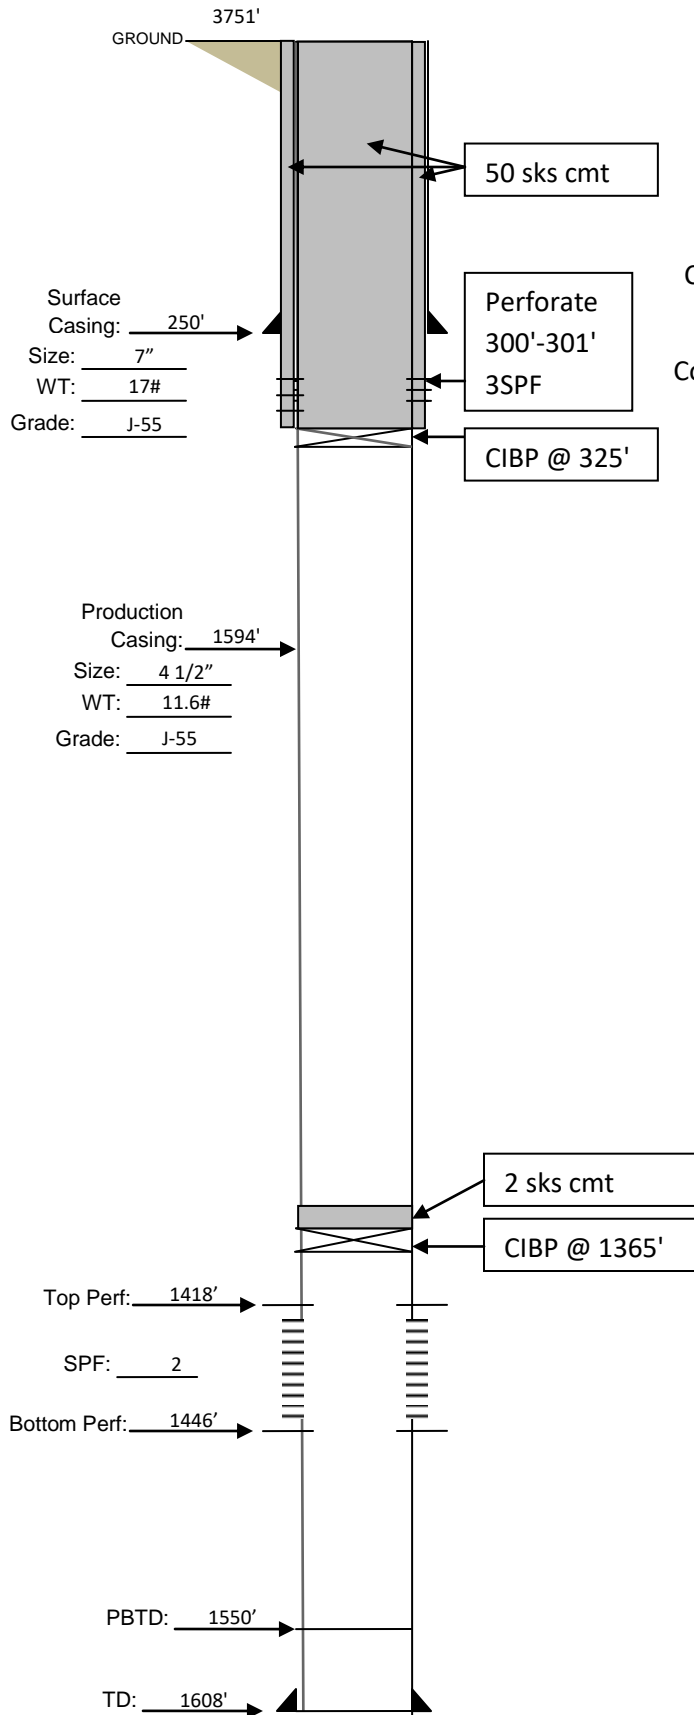

Well: Weyerman 6B-18

API: 05-125-09027-00

Location: 1614' FWL & 2449' FNL, SENW
Sec. 18, T5S-R43W; ELEV GL 3751'

County, State: Yuma, CO

Date: 11-30-2017

Co. Supervisor: Roelfs

Lat/Longs: 39.623557 / -102.2266