



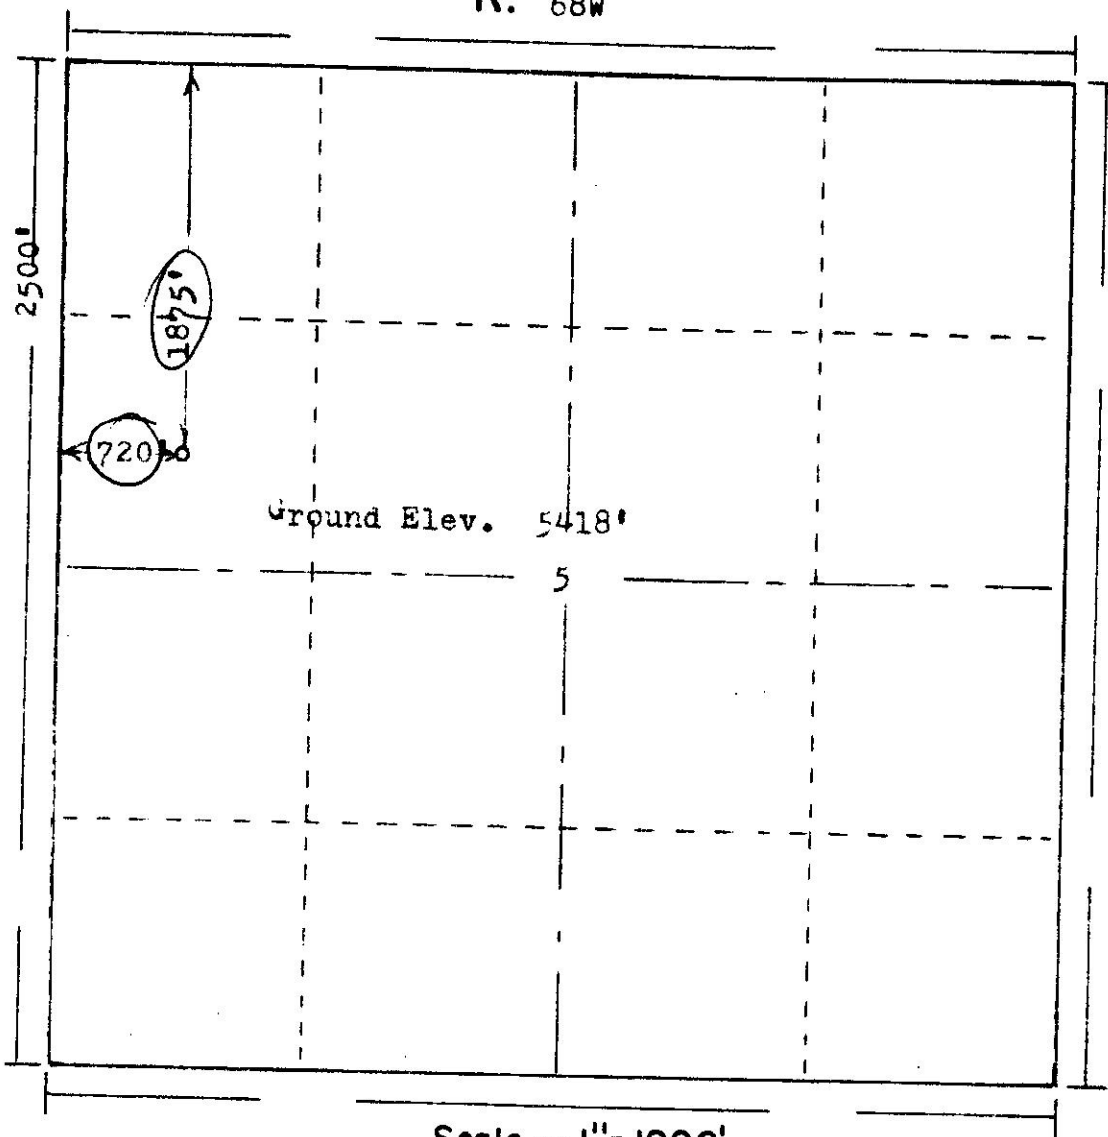
00255071

RECEIVED

APR - 6 1967

COLO. OIL & GAS CONS. COM. JAN 12 1967

R. 68W

T.
9
N

Scale 1" = 1000'

Powers Surveyors, Inc. of Denver, Colorado
has in accordance with a request from Mr. Hoovler
for Stuarco Oil-Bel Oil & Occidental determined the
Location of No.1 UPRR Petroleum
to be 1875'FN & 720'FW Section 5 Township 9N
Range 68W of the 6th Principal Meridian
Larimer County, Colorado

I hereby certify that this plat is an
accurate representation of a correct
survey showing the location of

Date: 1-7-67

Barry J. Hoovler
Licensed Land Surveyor No. 2853
State of Colorado