




CERTIFICATE OF SURVEY
for
Snyder Drilling Co.
Adams County, Colorado

RECEIVED

JAN 15 1974

COLO. OIL & GAS CONS. COMM.

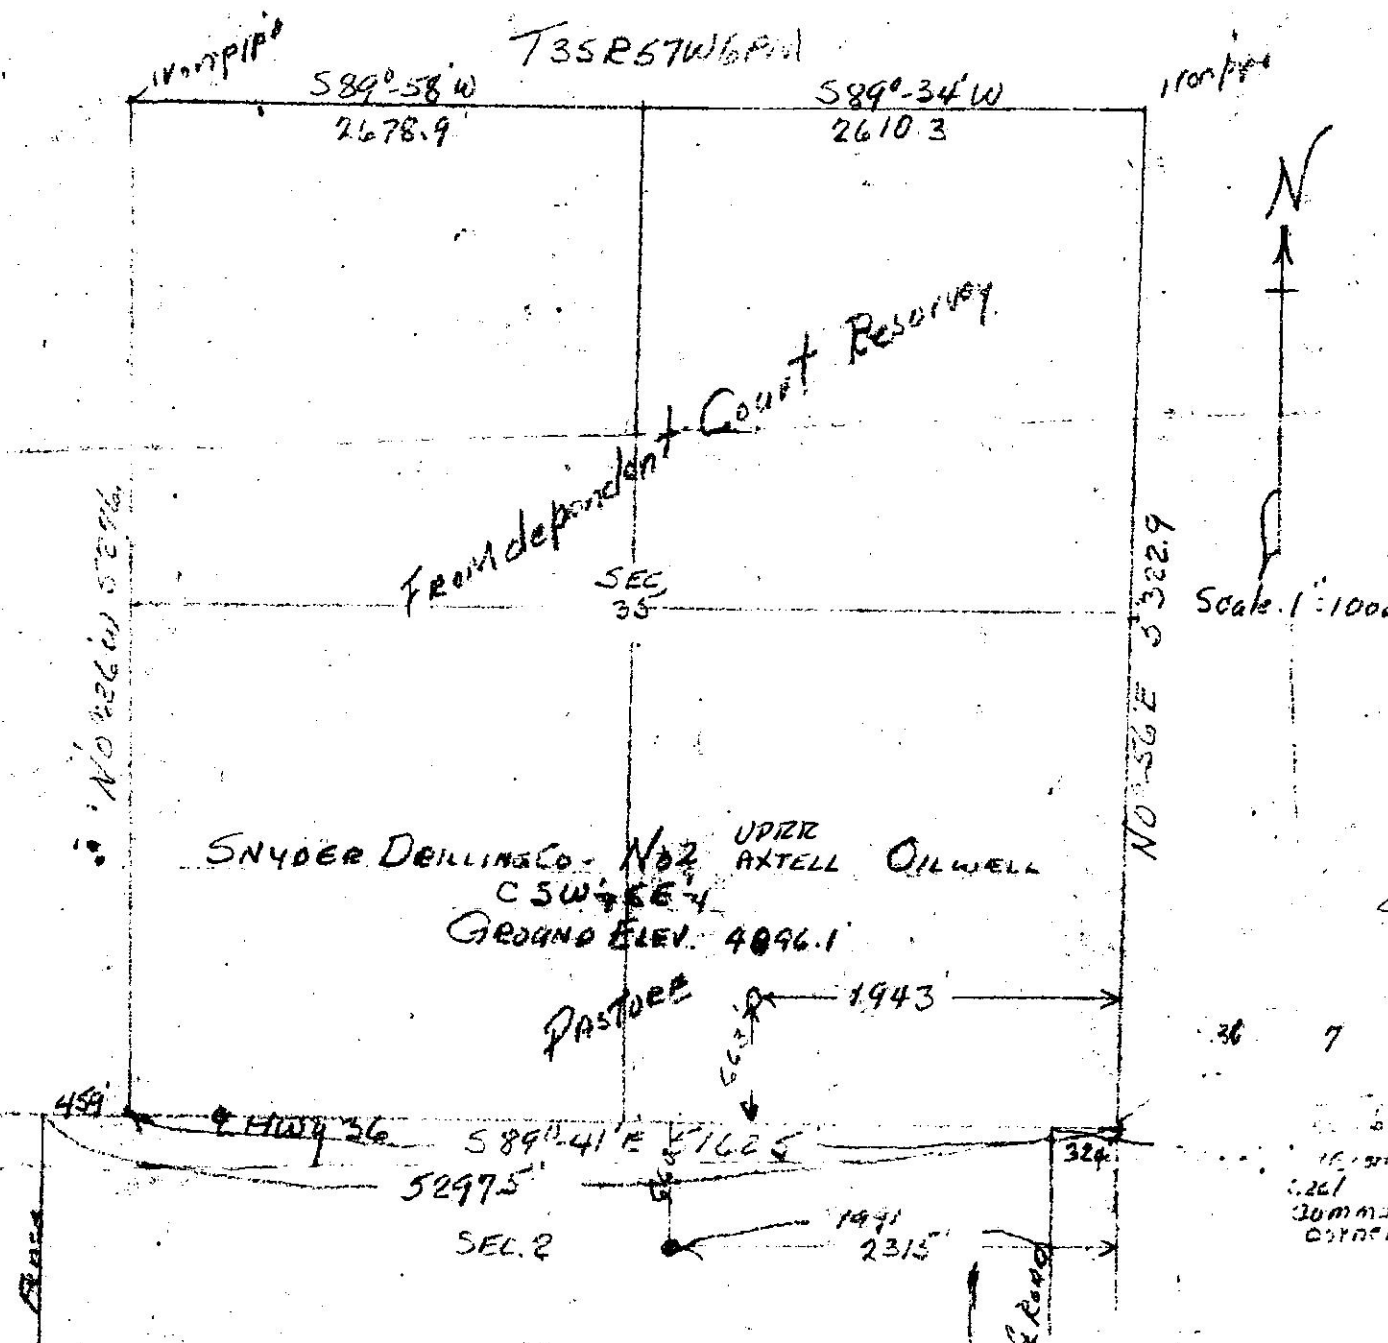

I hereby certify that the above plat is an accurate representation of a correct survey showing the location of Snyder Drilling Co.-No. 2 UPRR-Axtell Oilwell in C SW 1/4 Sec. 35 T35 R57W 6P1. The elevation of the ground at the stake is 4896.1 feet above sea level from U.S.C. & G. Bench Mark.

Fort Morgan, Colorado
Jan. 12, 1974

Lecil J. Osborne
Registered Professional Engineer
State of Colorado

73-1072

JERRIS