




CERTIFICATE OF SURVEY
for
Sundance Oil Co.
Adams County, Colorado

RECEIVED

APR 4 1979

COLD. OIL & GAS CONS. COMM.

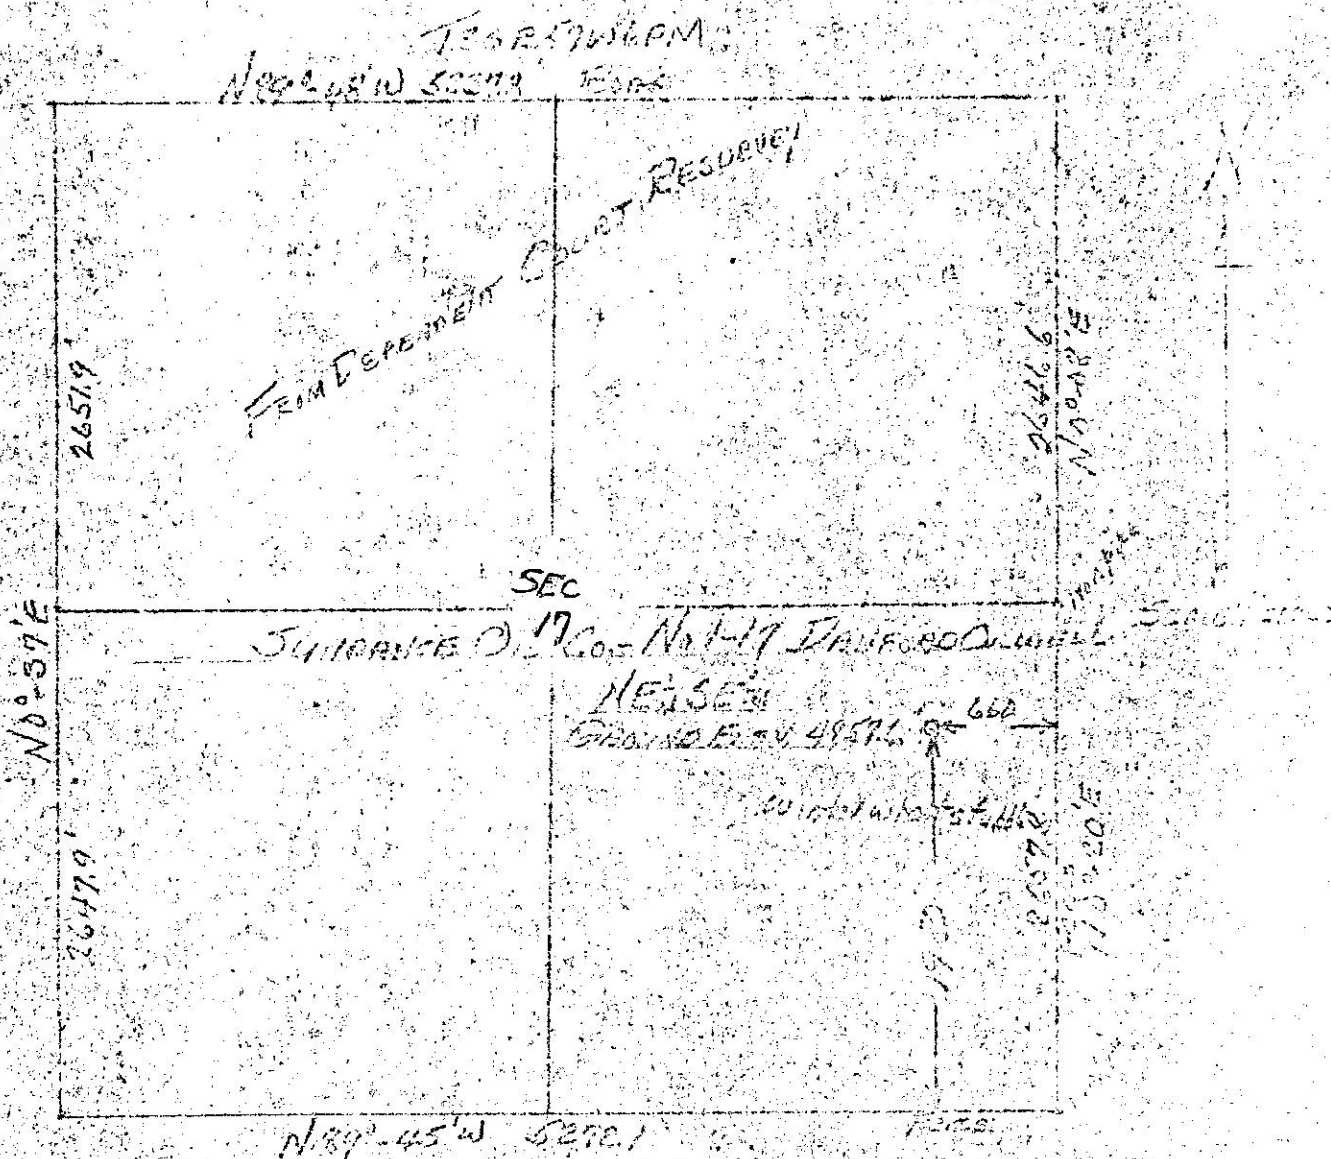

I hereby certify that the above plat is an accurate representation of a correct survey showing the location of Sundance Oil Co. No. 1-17 Danford Oilwell in NE 1/4 Sec. 17 T3S R57W 6PM. The elevation of the ground at the stake is 4857.6 feet above sea level from U.S.C.S. Bench Mark.

Fort Morgan, Colorado
March 30, 1979

Registered Professional Engineer
State of Colorado