


54 W



00217957

OFFICE OF STATE OIL INSPECTOR  
Oil and Gas Conservation  
Department

LOG OF OIL AND GAS WELL

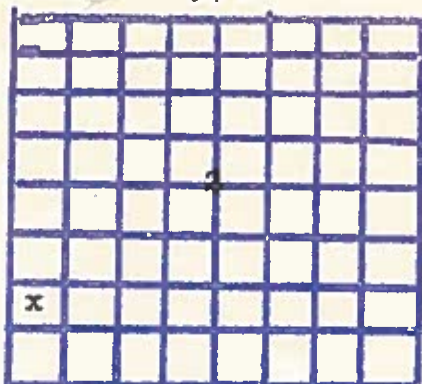

Locate  
Well  
Correctly

8 N

Maude Knutson #2

Company British-American Oil Prod. Co. Address Box 620, Casper, Wyoming.  
State or Patented Patented Field Yenter Block State Colorado  
Well No. 2 Sec. 2 T. 8 N R. 54 W Meridian County Logan  
Location 990 Ft. (N) of S Line and 330 Ft. (E) of W line of SW/4 Elevation 4300 G.L.  
(Derrick floor relative to sea level)

The information given herewith is a complete and correct record of the well and all work done thereon so far as can be determined from all available records.

Date November 8, 1951.

Signed [Signature]  
Title District Superintendent

The summary on this page is for the condition of the well as above date.

Commenced drilling September 3, 1951 Finished Drilling September 19 51

OIL SANDS OR ZONES

October 18,

No. 1, from 5003 to 5040 "D" No. 4, from        to         
No. 2, from 5108 to not drilled "J" No. 5, from        to         
No. 3, from        to        No. 6, from        to       

IMPORTANT WATER SANDS

No. 1, from        to        No. 3, from        to         
No. 2, from        to        No. 4, from        to       

CASING RECORD

Size	Weight per ft.	Threads per inch	Make	Amount	Kind of Shoe	Cut & Pulled from	Perforated From	to	Purpose
10-3/4	29	8 Rd	Armco	200					
5 1/2	15.5	8 Rd	J-55	5155	Baker		5137	5138	

MUDDING AND CEMENTING RECORD

Size	Where Set	No. Sacks of Cement	Methods used	Mud Gravity	Amount of Mud Used
10-3/4	218 KB	160	HOWCO		
5 1/2	5155 KB	250	HOWCO		

PLUGS AND ADAPTERS

Heaving plug-Material        Length        Depth Set         
Adapters-Material        Size       

SHOOTING RECORD

Size	Shell Used	Explosive Used	Quantity	Date	Depth Shot	Depth Cleaned Out

TOOLS USED

Rotary Tools used from 0 ft. to 5156 ft. and from        ft. to        ft.  
Cable tools were used from 5085 ft. to 5150 ft. and from        ft. to        ft.

DATES

November 8, 1951. Put to producing October 22 19 51

The production for the first 24 hours was 152 barrels of fluid of which

100 % was oil,        % emulsion;        % sediment. Gravity Be, 38 Est.

If gas well, cu. ft. per 24 hours        Gallons gasoline per 1,000 cu. ft.

of gas        Rock Pressure, lbs. per sq. in.       

EMPLOYEES

Herndon Drilling Company Driller       , Driller         
Driller       , Driller       

FORMATION RECORD

From	To	Total Feet	Formation
0	220	220	Surface
220	4520	4300	Shale
4520	4780	260	Lime
4780	5030	250	Shale & Lime
5030	5156	126	Sand
5156			TD

*Handwritten signature*