




FORM F-106

RECEIVED

JAN 14 1975

Permit 74-297 N

GOLD. OIL & GAS CONS. COMPR. 53W

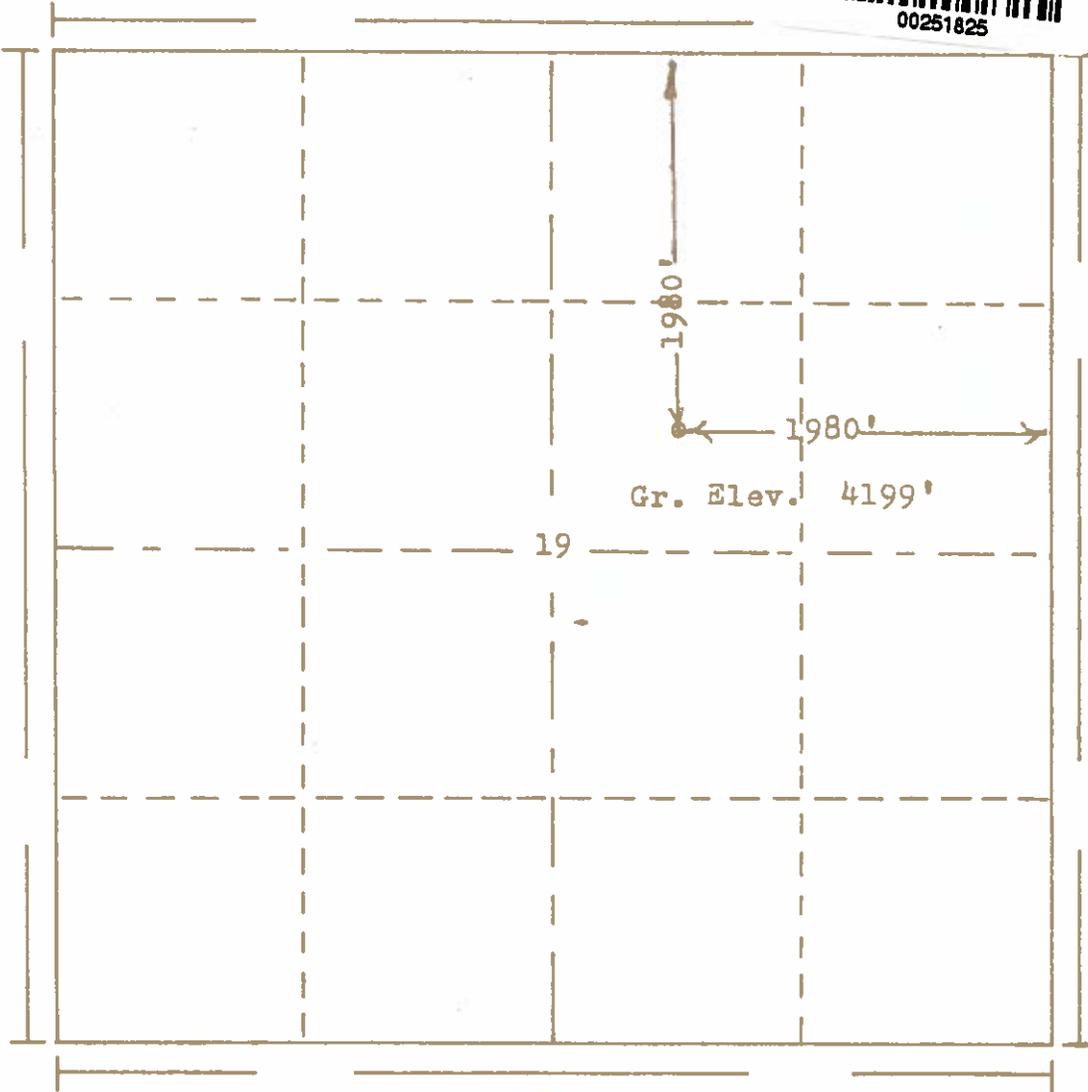

T.
8
N

Scale... 1" = 1000'

Powers Elevation Company, Inc. of Denver, Colorado has in accordance with a request from Jo for J.W. Gibson Well Service, Inc.

determined the location of No.1 State to be CSW NE Section 19 Township 8N Range 53W of the 6th Principal Meridian Logan County, Colorado

I hereby certify that this plat is an accurate representation of a correct survey showing the location of

Date: 1-2-75

David J. Hallock
Licensed Land Surveyor No. 2855
State of Colorado

File