


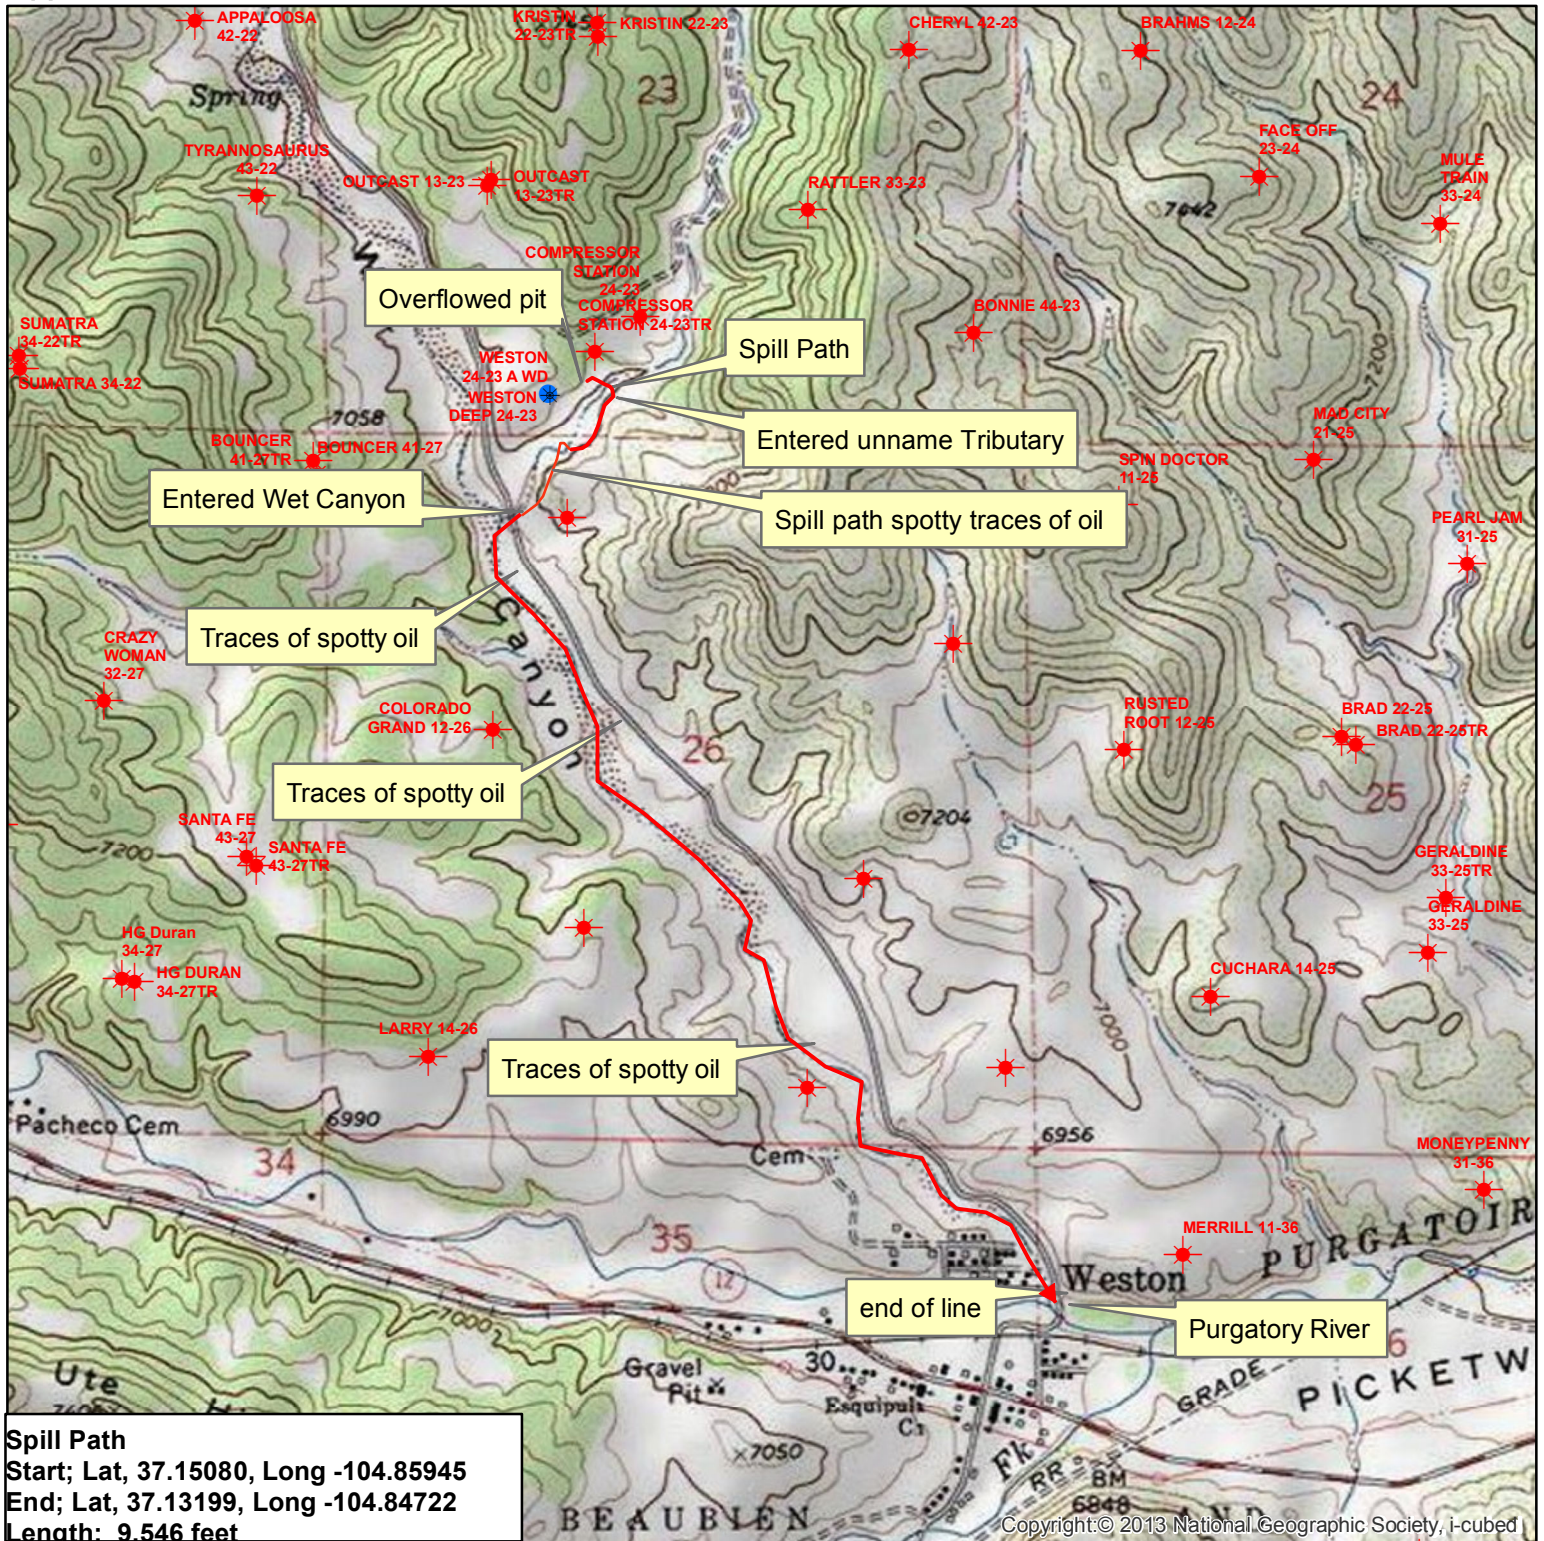

Topographical Spill Map

Weston 24-23 WD Spill Map



★ Permitted Well

— Spill Path

0 870 1,740 2,610 3,480
Feet

1:17,128