


North ↑

1/04/2018

Lark 33-5 #21-4

API 05-007-06323

Spill drawing

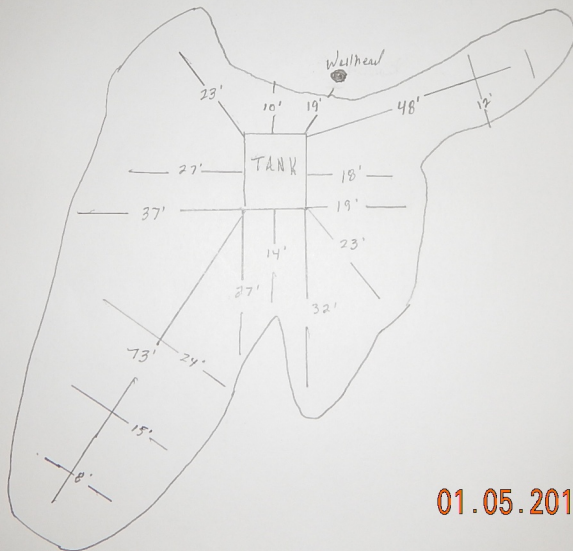

01.05.2018 09:30